


CENTRAL ADDITION

TO
OLYMPIA

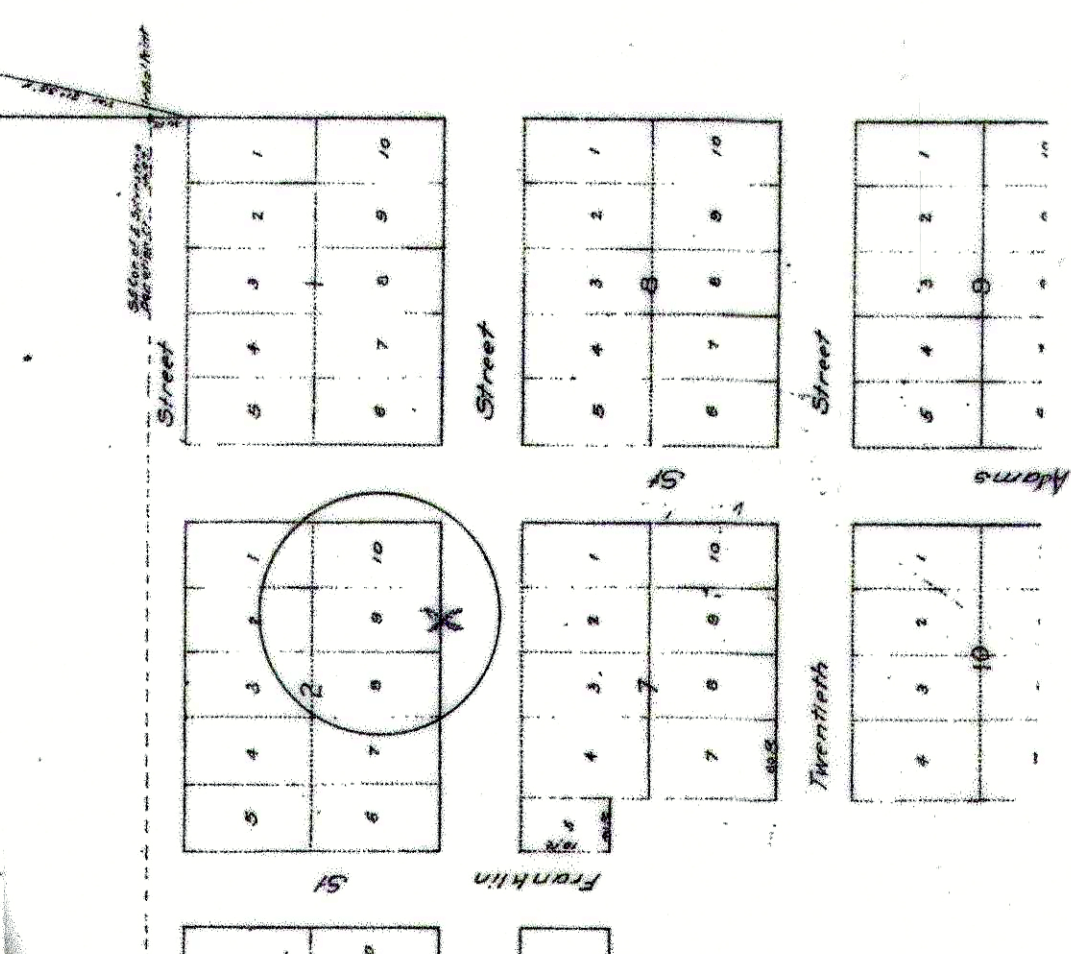

PLOT MAP

AFTER RECORDING MAIL TO:
JILL MARIE SATRAN
318 19TH AVE SE
OLYMPIA, WA 98501

THURSTON COUNTY Treasurer
Real Estate Selling Permit: 44450-00
By: *Mark Anderson* Deputy
7 MAY '04 8208590

Encrow No.: 0013051
Statutory Warranty Deed 9/1305316

THE GRANTOR MARK L. ANDERSON, a single person for and in consideration of Ten Dollars and other valuable consideration in hand paid, convey and warrant to JILL MARIE SATRAN, a single person, as her separate estate the following described real estate, situated in the County of THURSTON, State of Washington:

Lot 9 in Block 2 of Central Addition to Olympia as recorded in Volume 1 of Plats, page 46.

SUBJECT TO covenants, conditions, restrictions, interventions, easements and agreements of record, if any.

Assessor's Property Tax Parcel Account Number(s): 9446-02-00940

Dated this 3RD day of May, 2004.

Mark Anderson
MARK L. ANDERSON

STATE OF WASHINGTON
COUNTY OF THURSTON

I, *Mark Anderson*, certify that I know or have satisfactory evidence that MARK L. ANDERSON is the person who appeared before me, and said person acknowledged that HE signed this instrument and acknowledged it to be HIS free and voluntary act for the uses and purposes mentioned in this instrument.


Dated: 5-6-04



LEGAL DESCRIPTION

318 19TH AVE SE

SITE PLAN

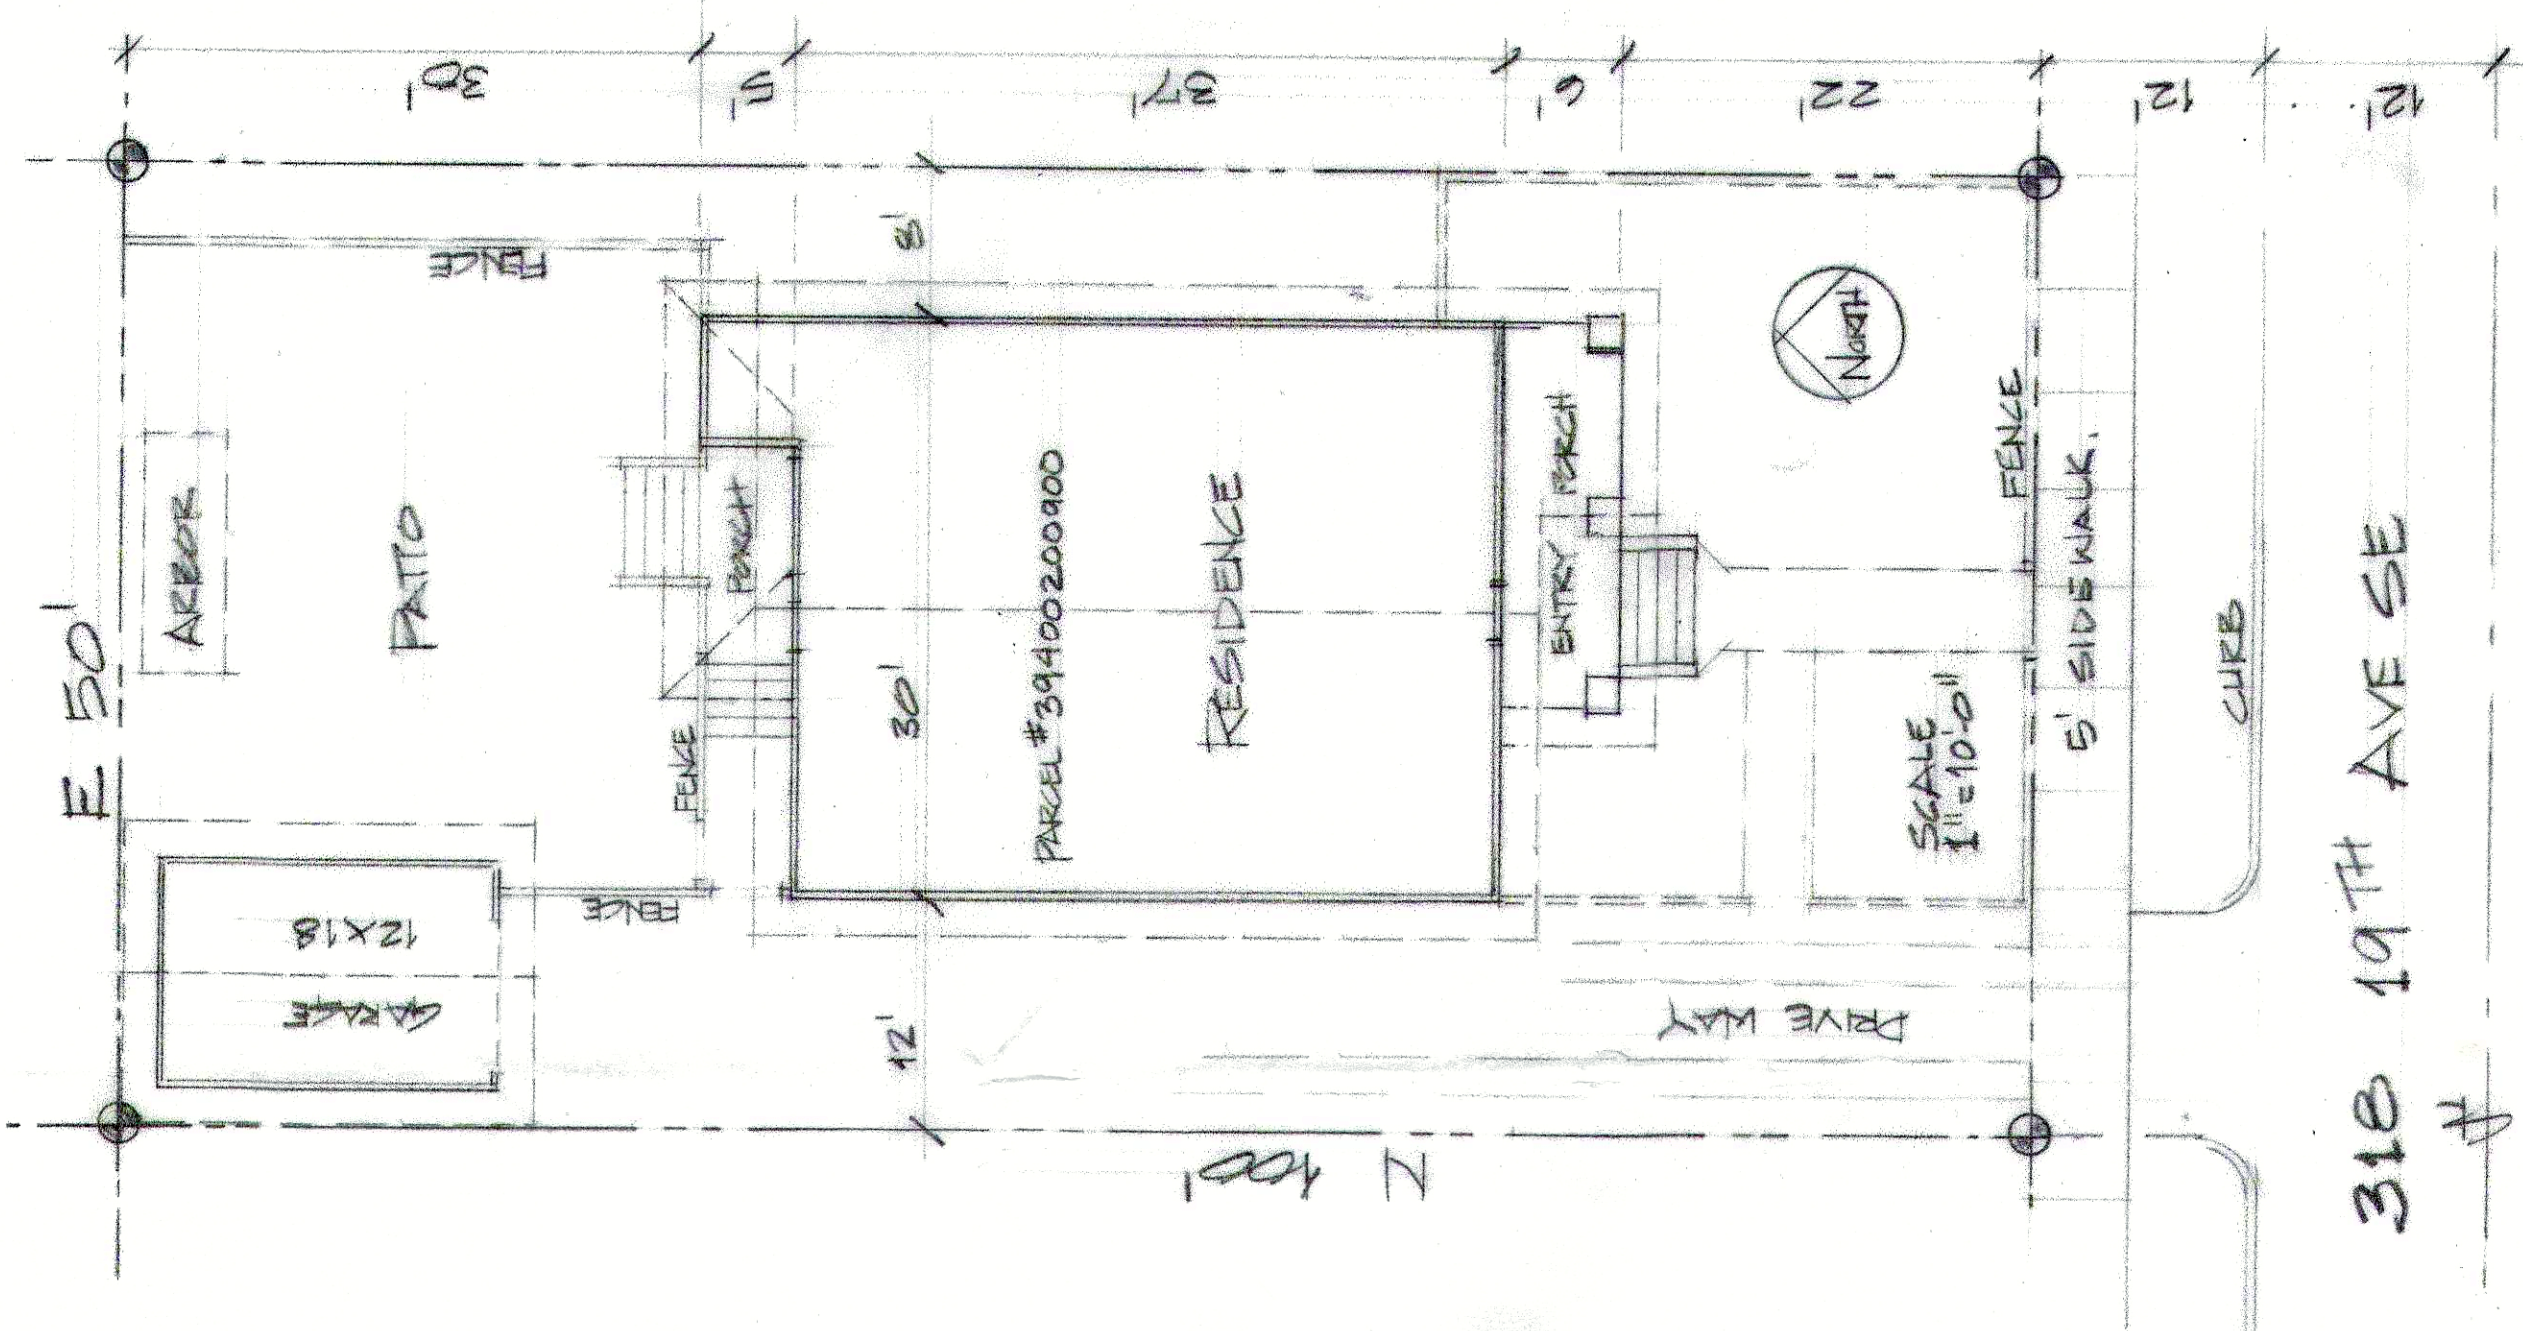

VICINITY MAP


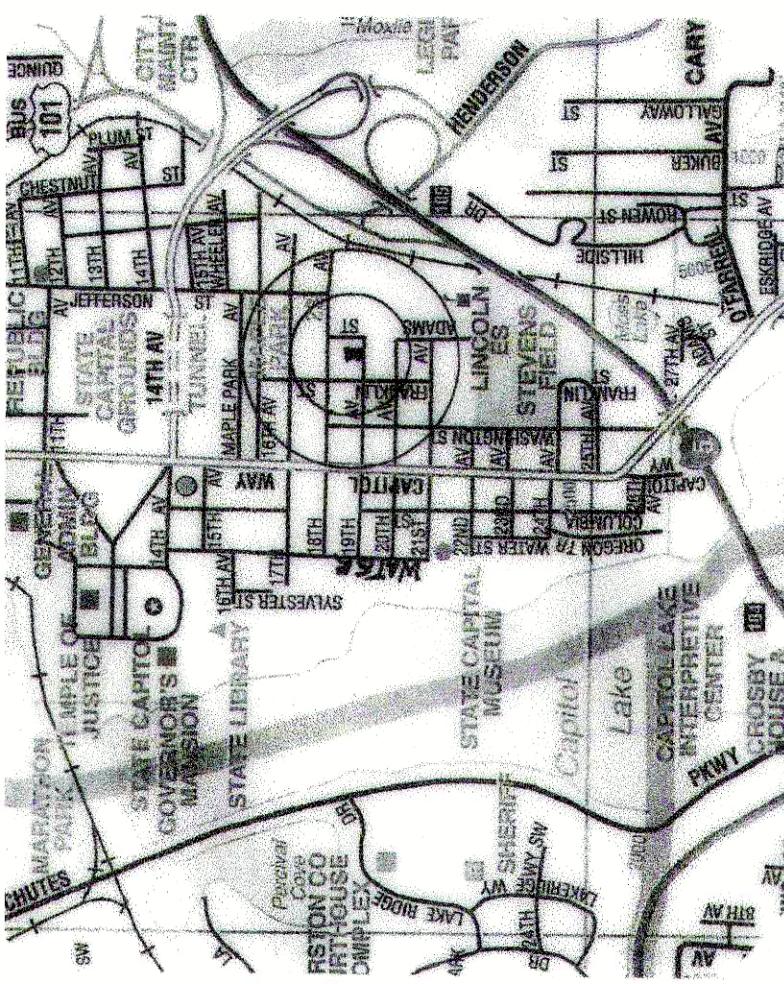


PHOTO REAR



PHOTO - FRONT

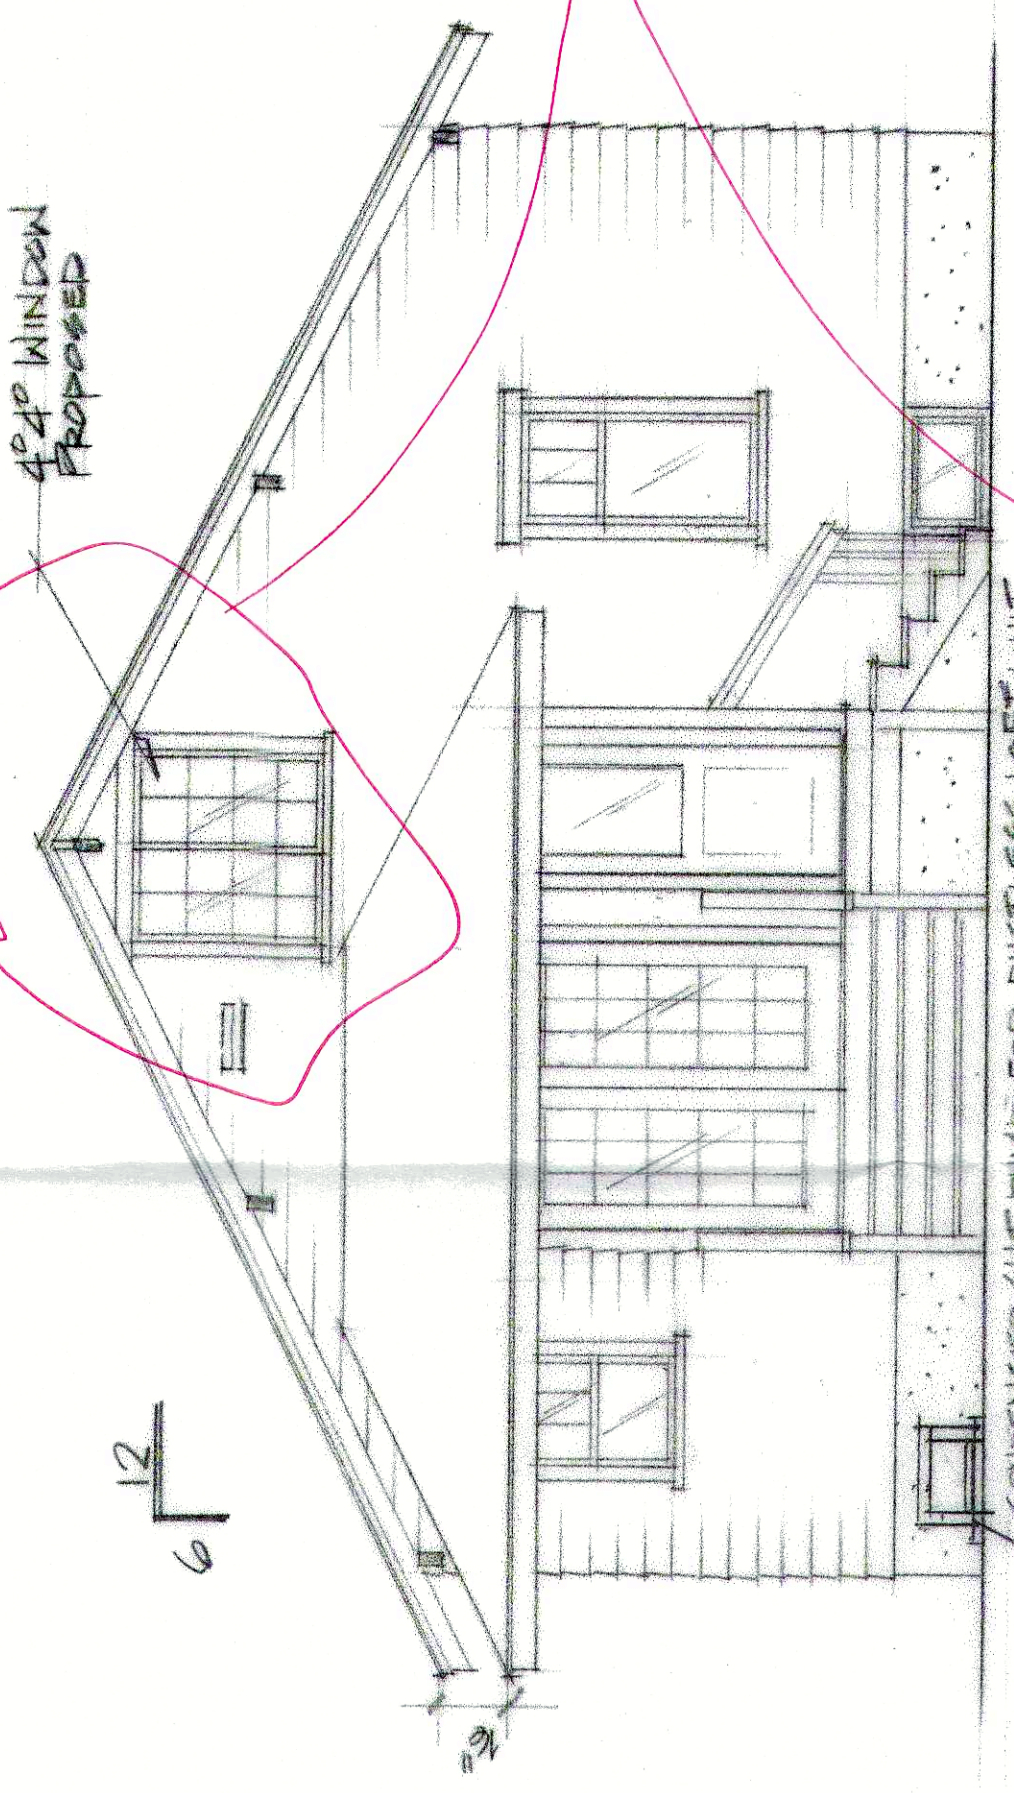


REAR ELEV. 3

Per field inspection
Conditions at time of inspection may require
modification to ensure code compliance
City of Olympia

OCT 27 2017

COMMUNITY PLANNING
AND DEVELOPMENT DEPARTMENT

CONDENSER/HT PUMP FOR DUCTLESS LOFT UNIT

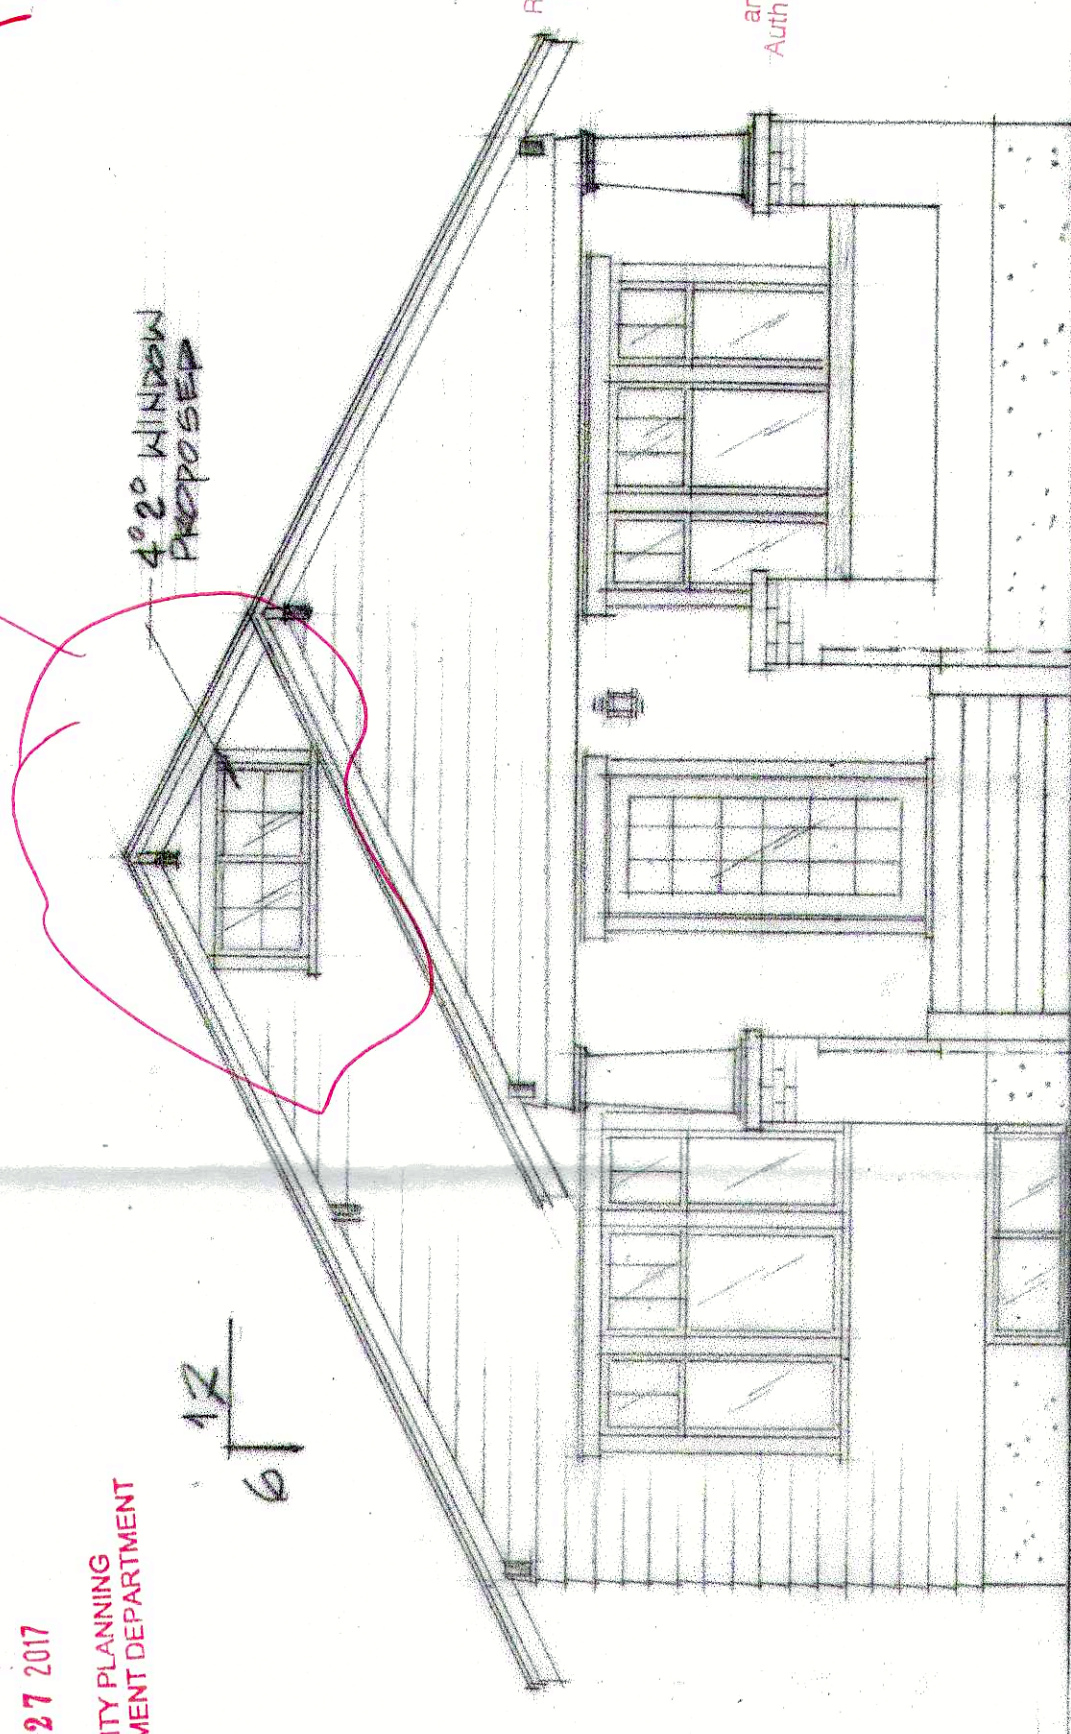

FRONT ENTRY ELEV. 1

174670 RR B

SATRAN, JILL

318 19TH AVE SE



F-033989

PROPOSED PARTIAL FINISHED ATTIC LOFT WINDOWS
OWNER: JILL M. SATRAN 318 19TH AVE SE OLYMPIA, WA 98501


OFFICE COPY

10/25/2017



inspector
notified
prior to exterior changes
a 4'2" window
a 4'2" window
a 4'2" window




Hondo Laves
Architect AIA
350-943-4067
Cell: 350-487-1046
email: hondo@comcast.net
805 Carlyon Ave.
Olympia, WA 98501

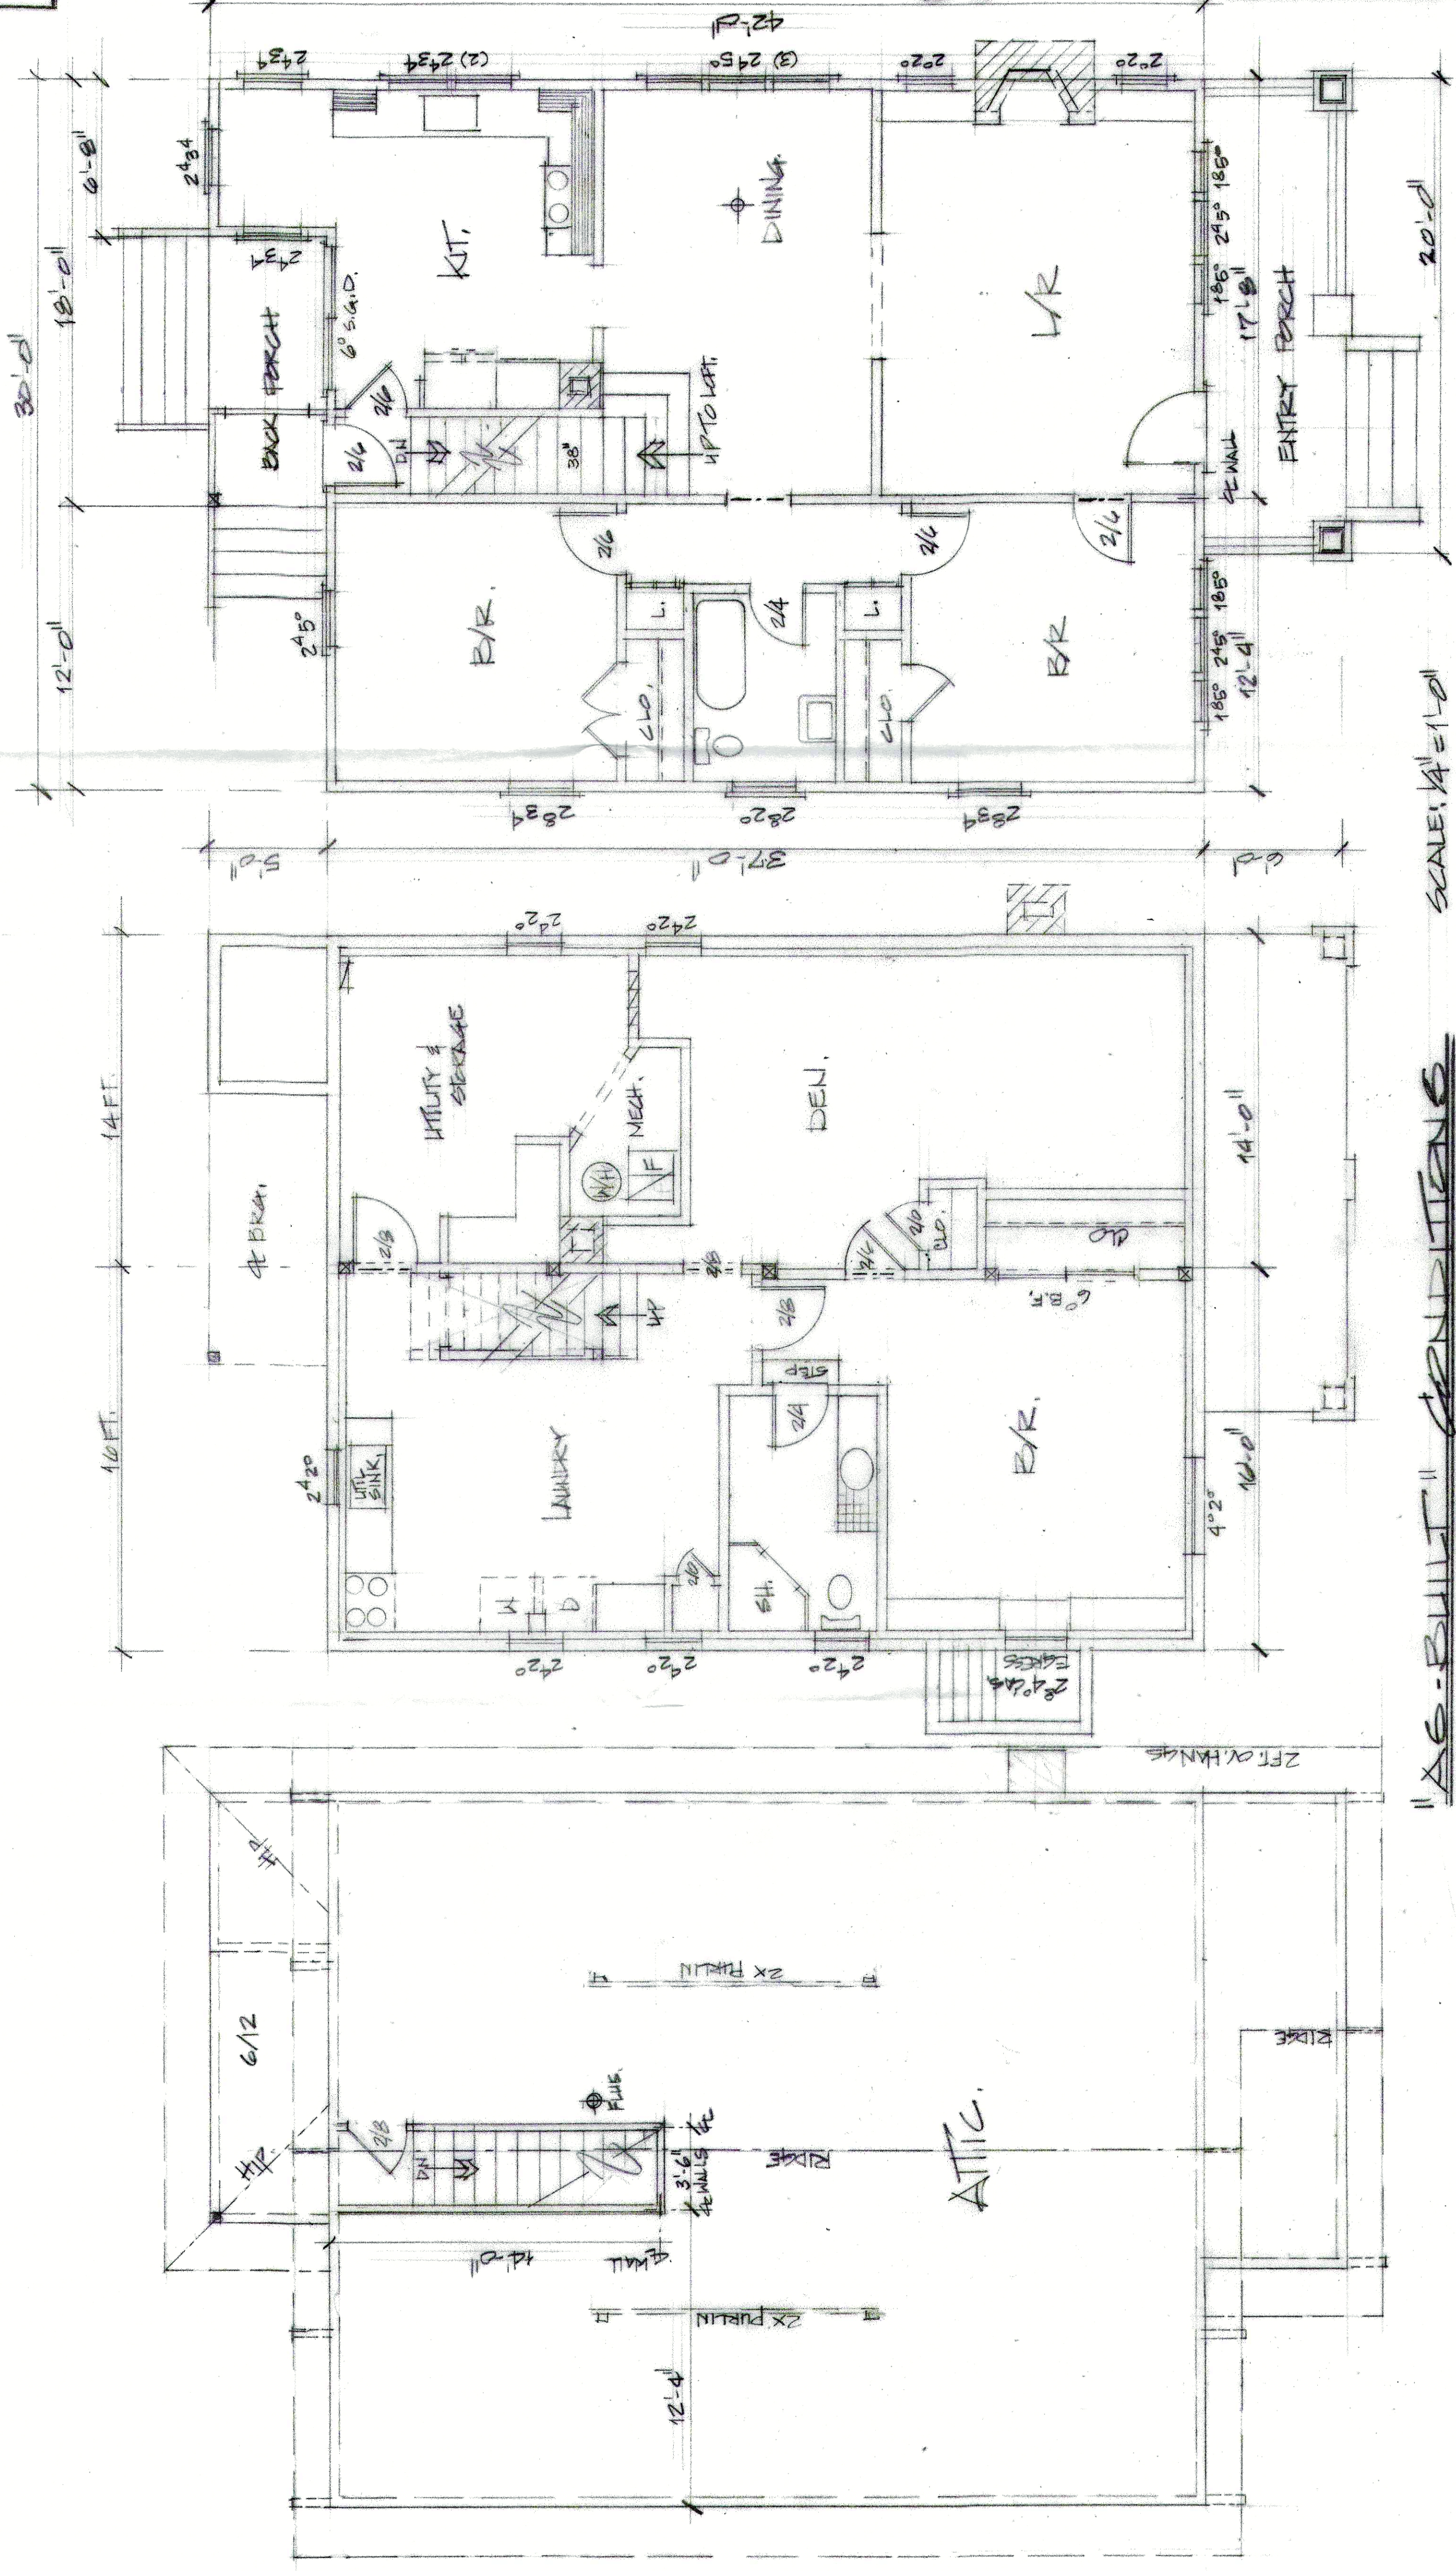

"AS-BUILT" CONDITIONS SCALE: 1/4" = 1'-0"
 BASEMENT FLOOR PLAN 2
 LOFT PLAN 3
 MAIN FLOOR PLAN 1

Honda Laves
 Architect AIA
 380-843-4067
 Cell: 980-421-1045
 email: hondasaves@aia.org
 805 Carlin Ave.
 Olympia, WA 98501

10/25/2017

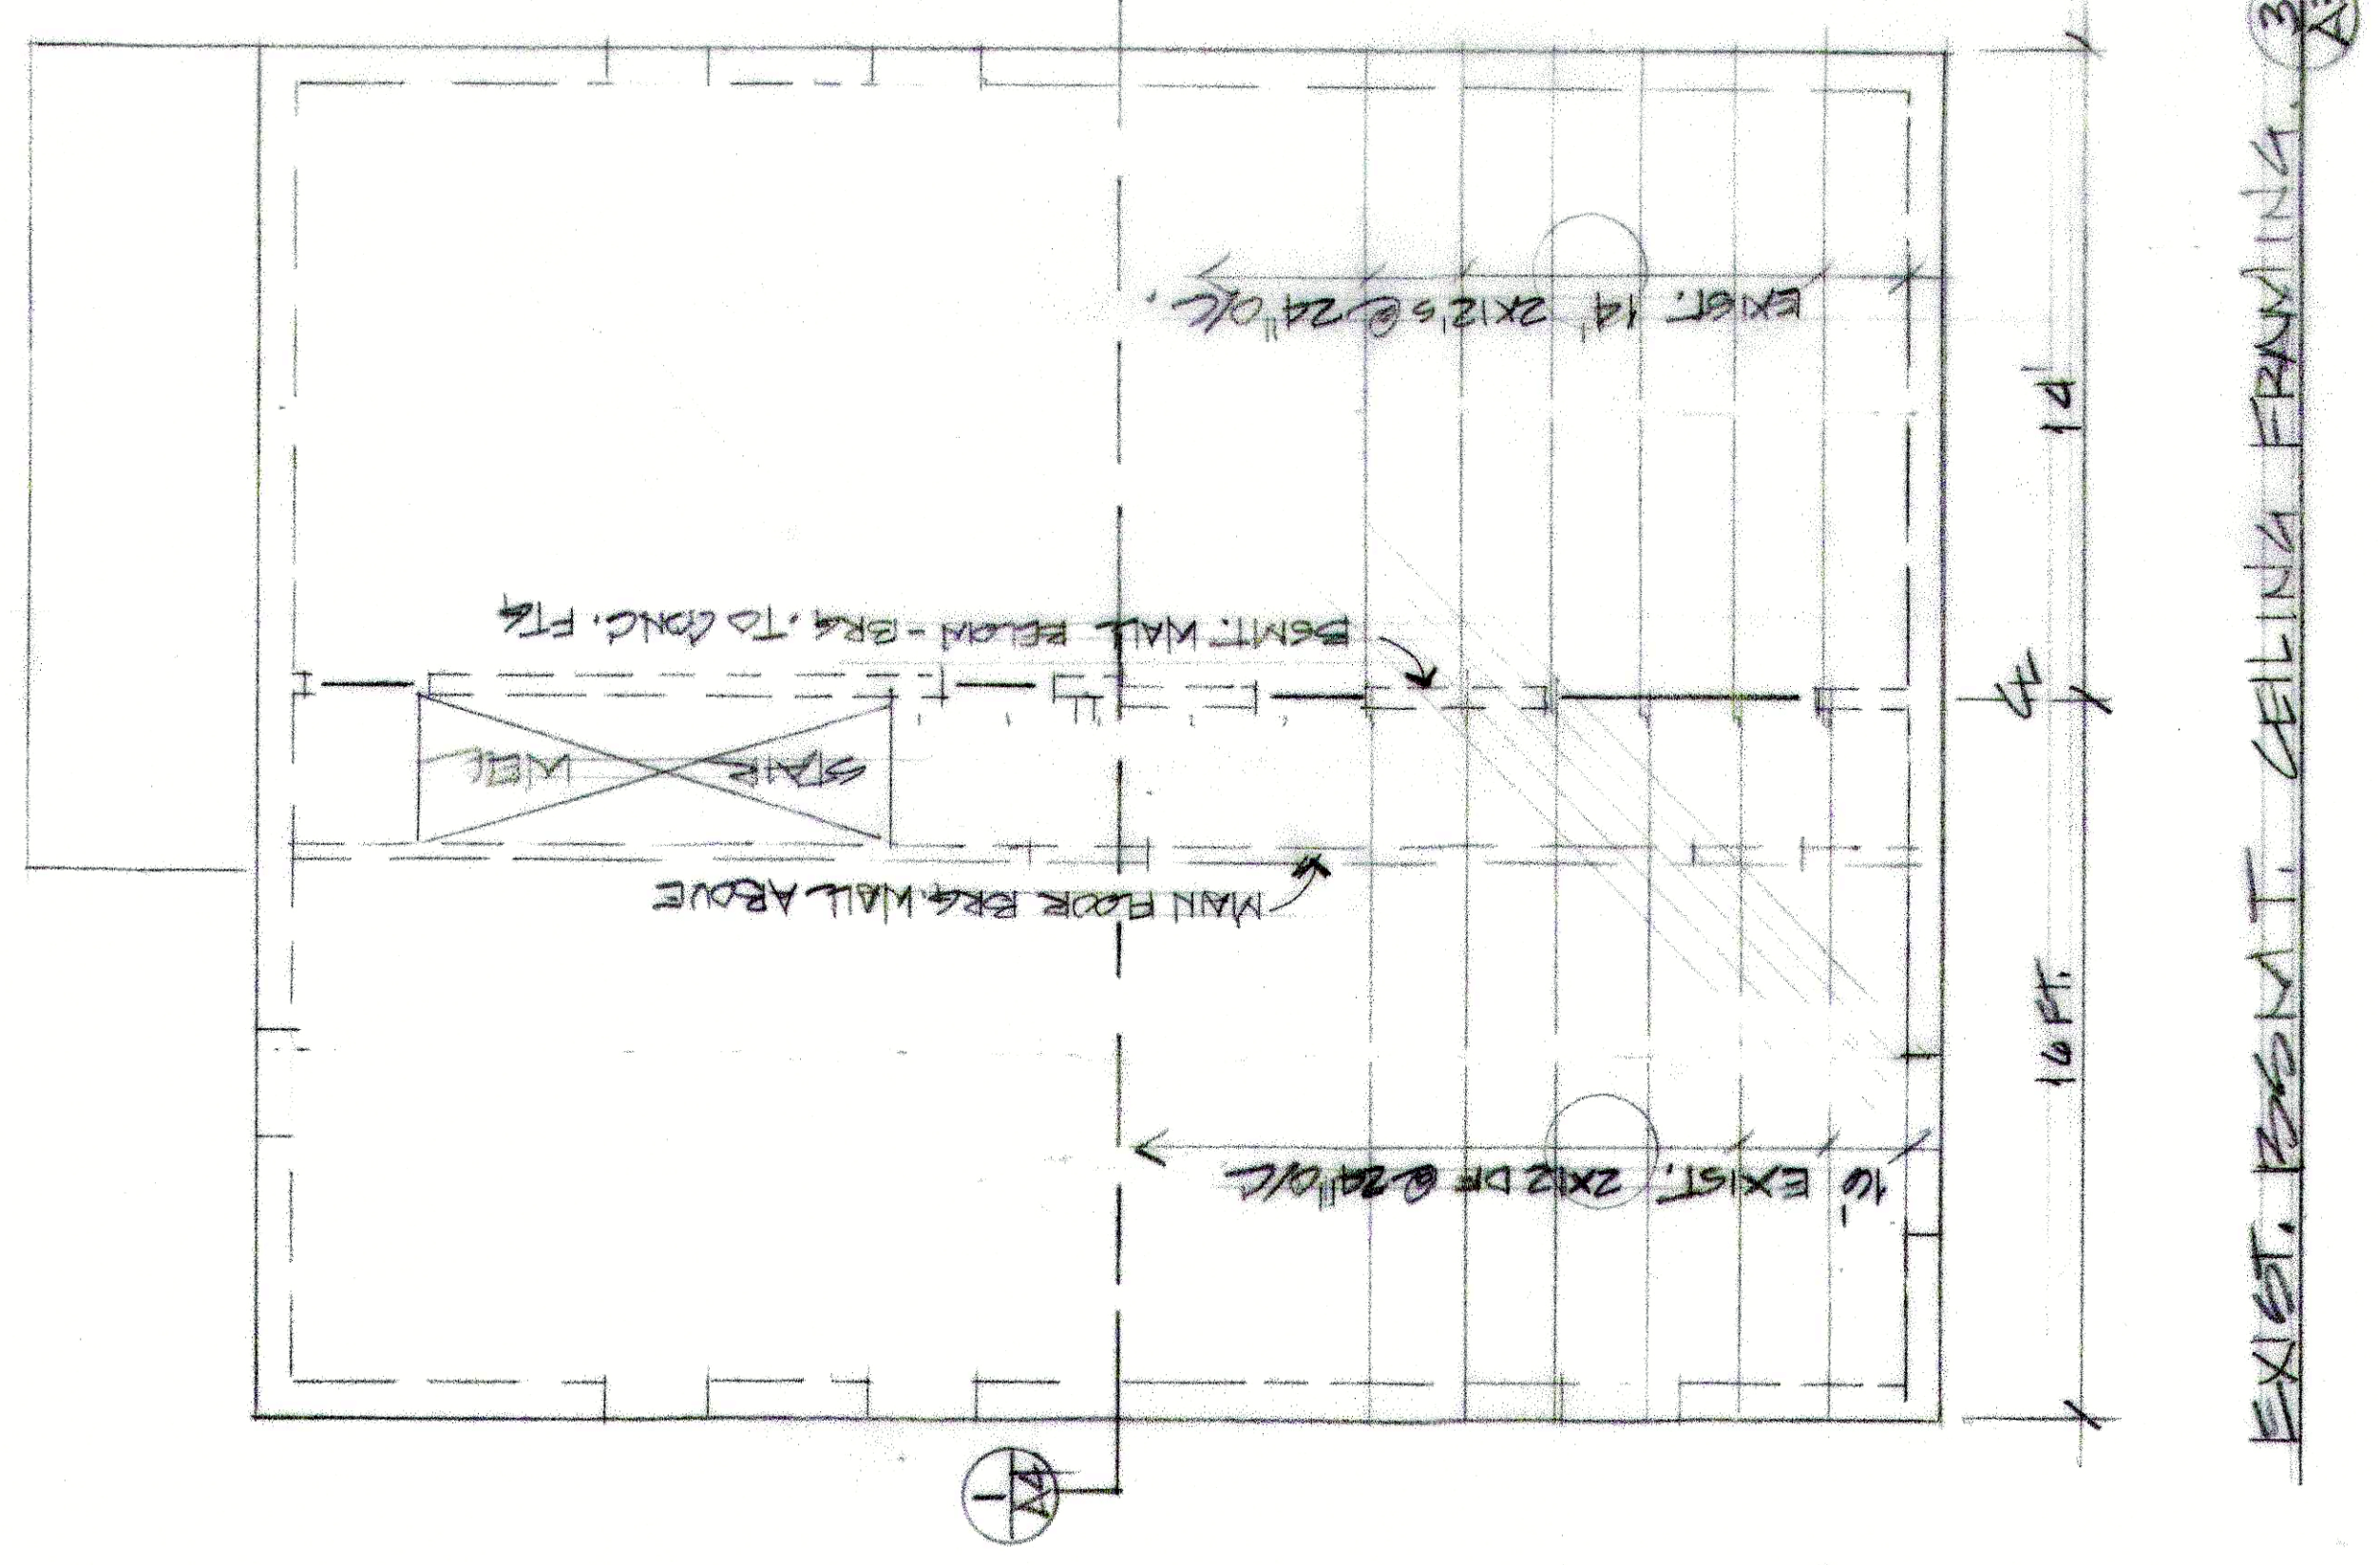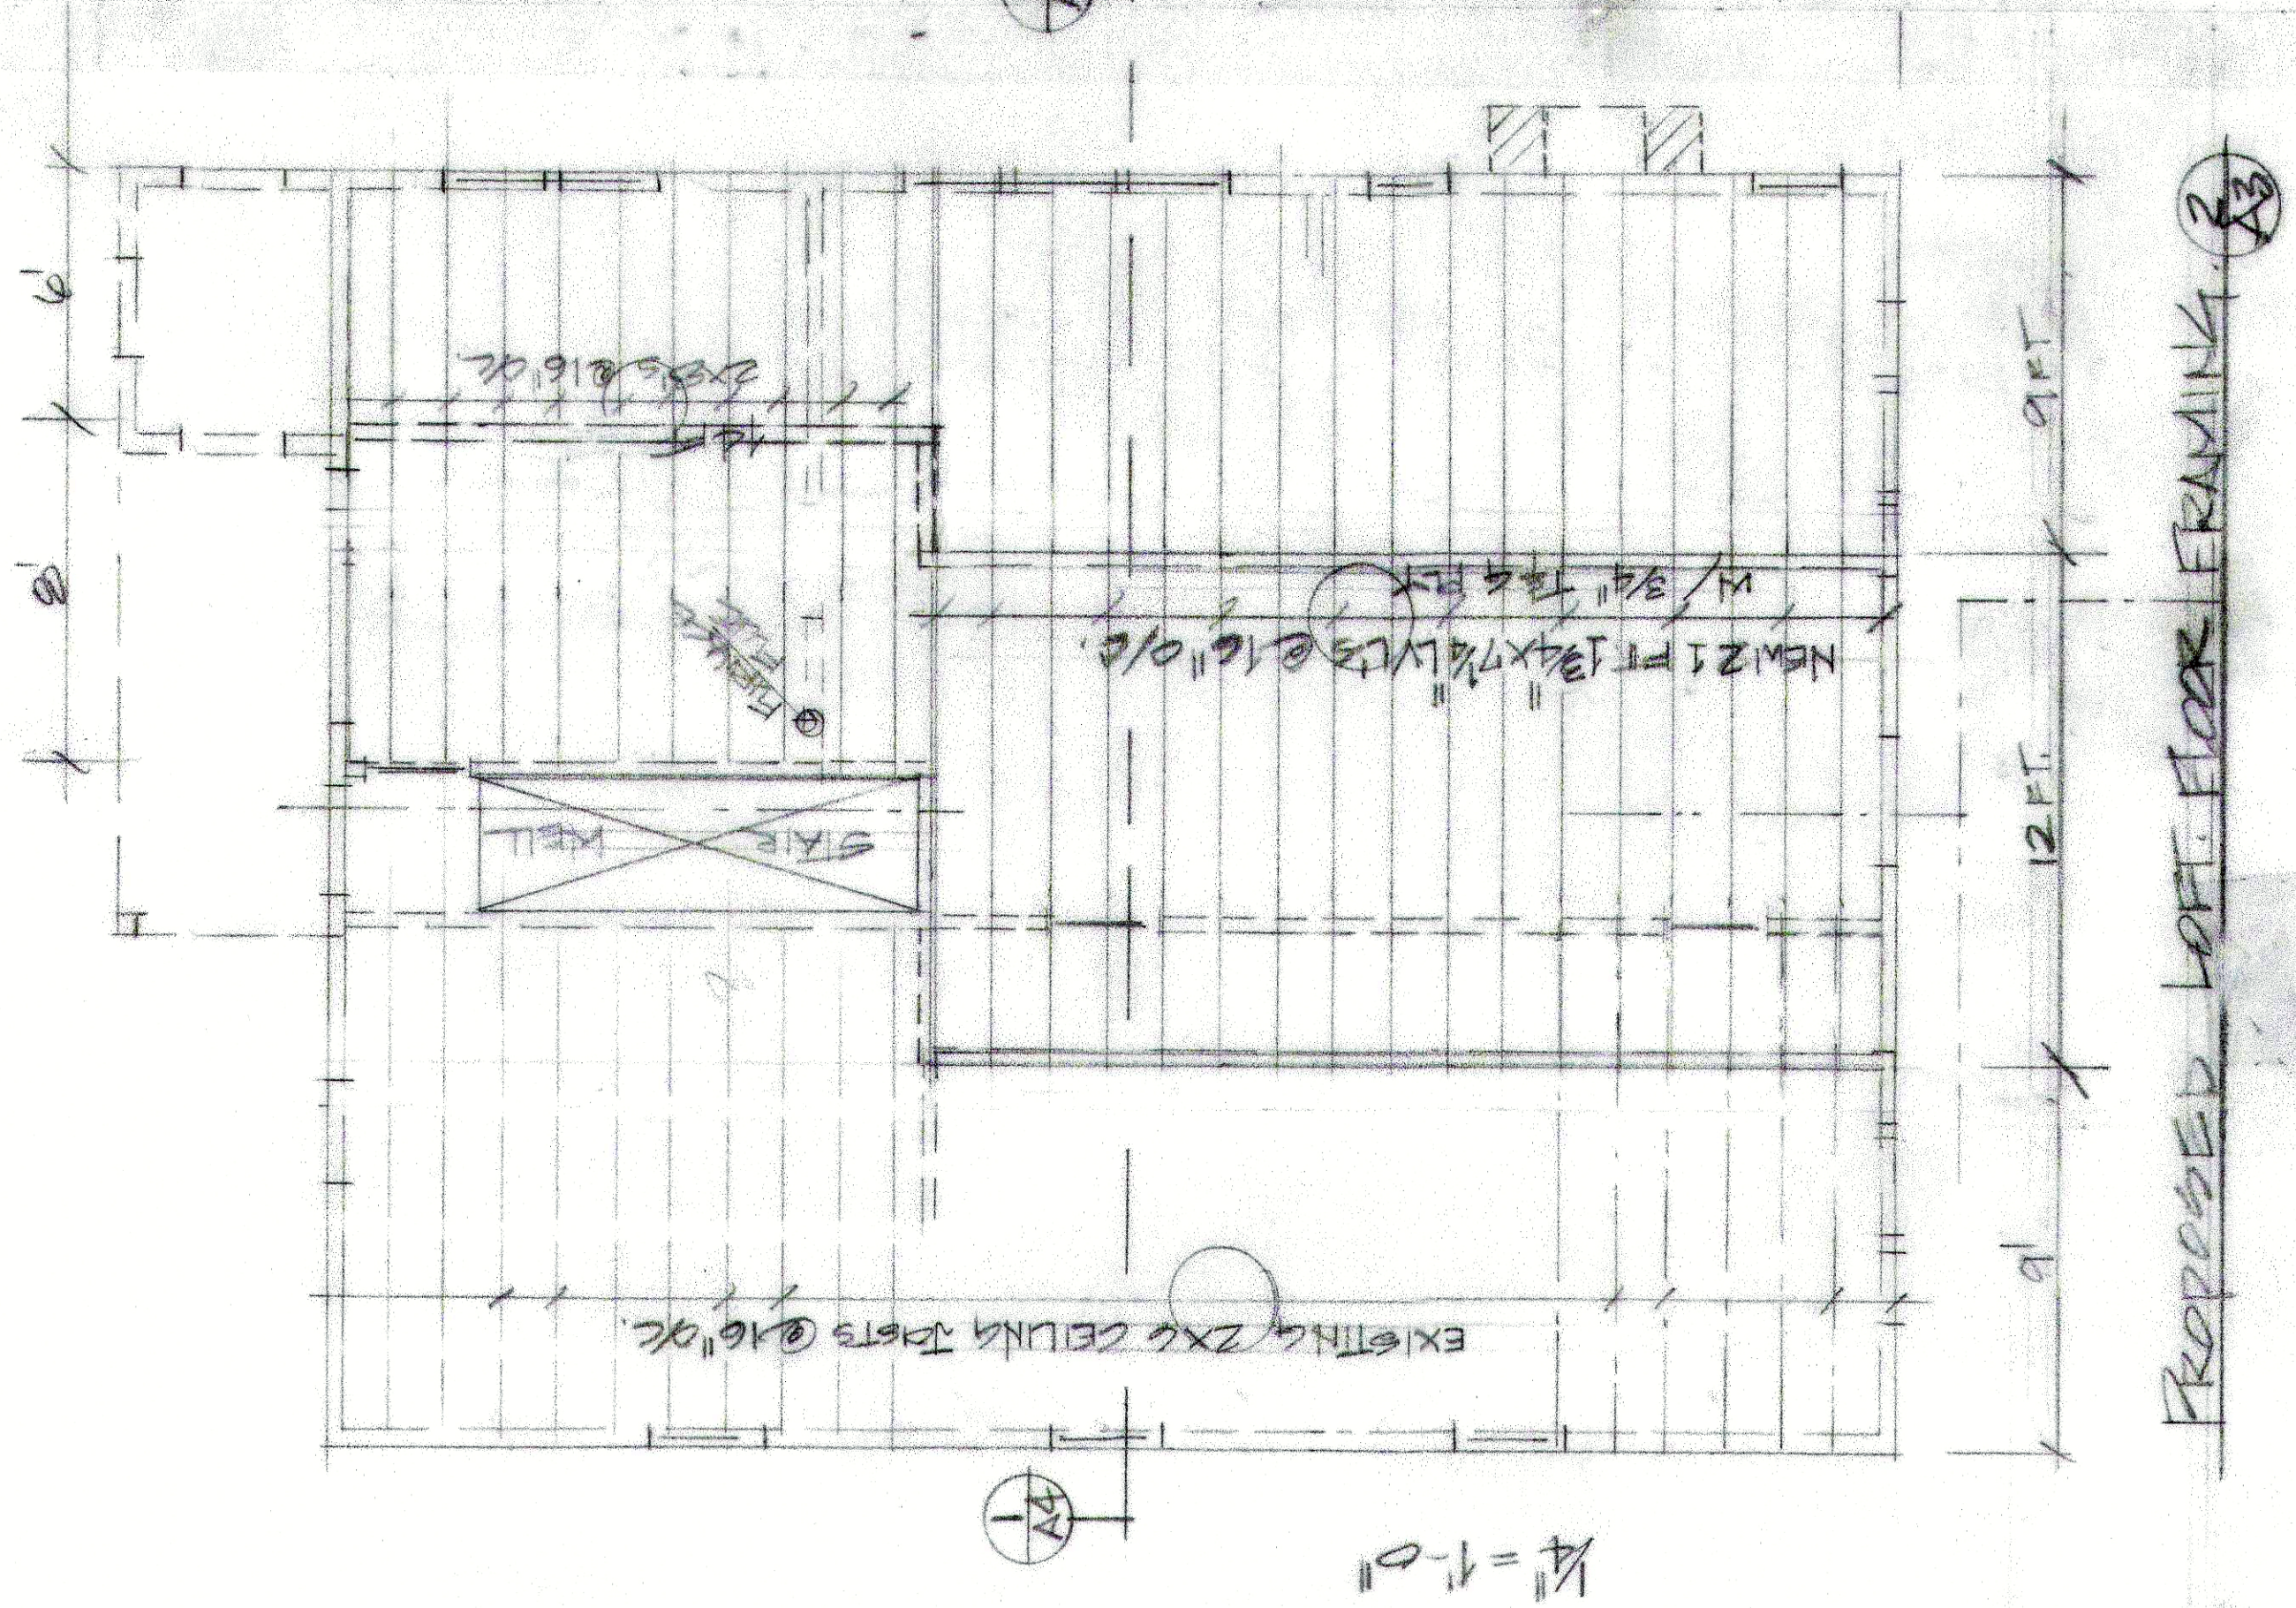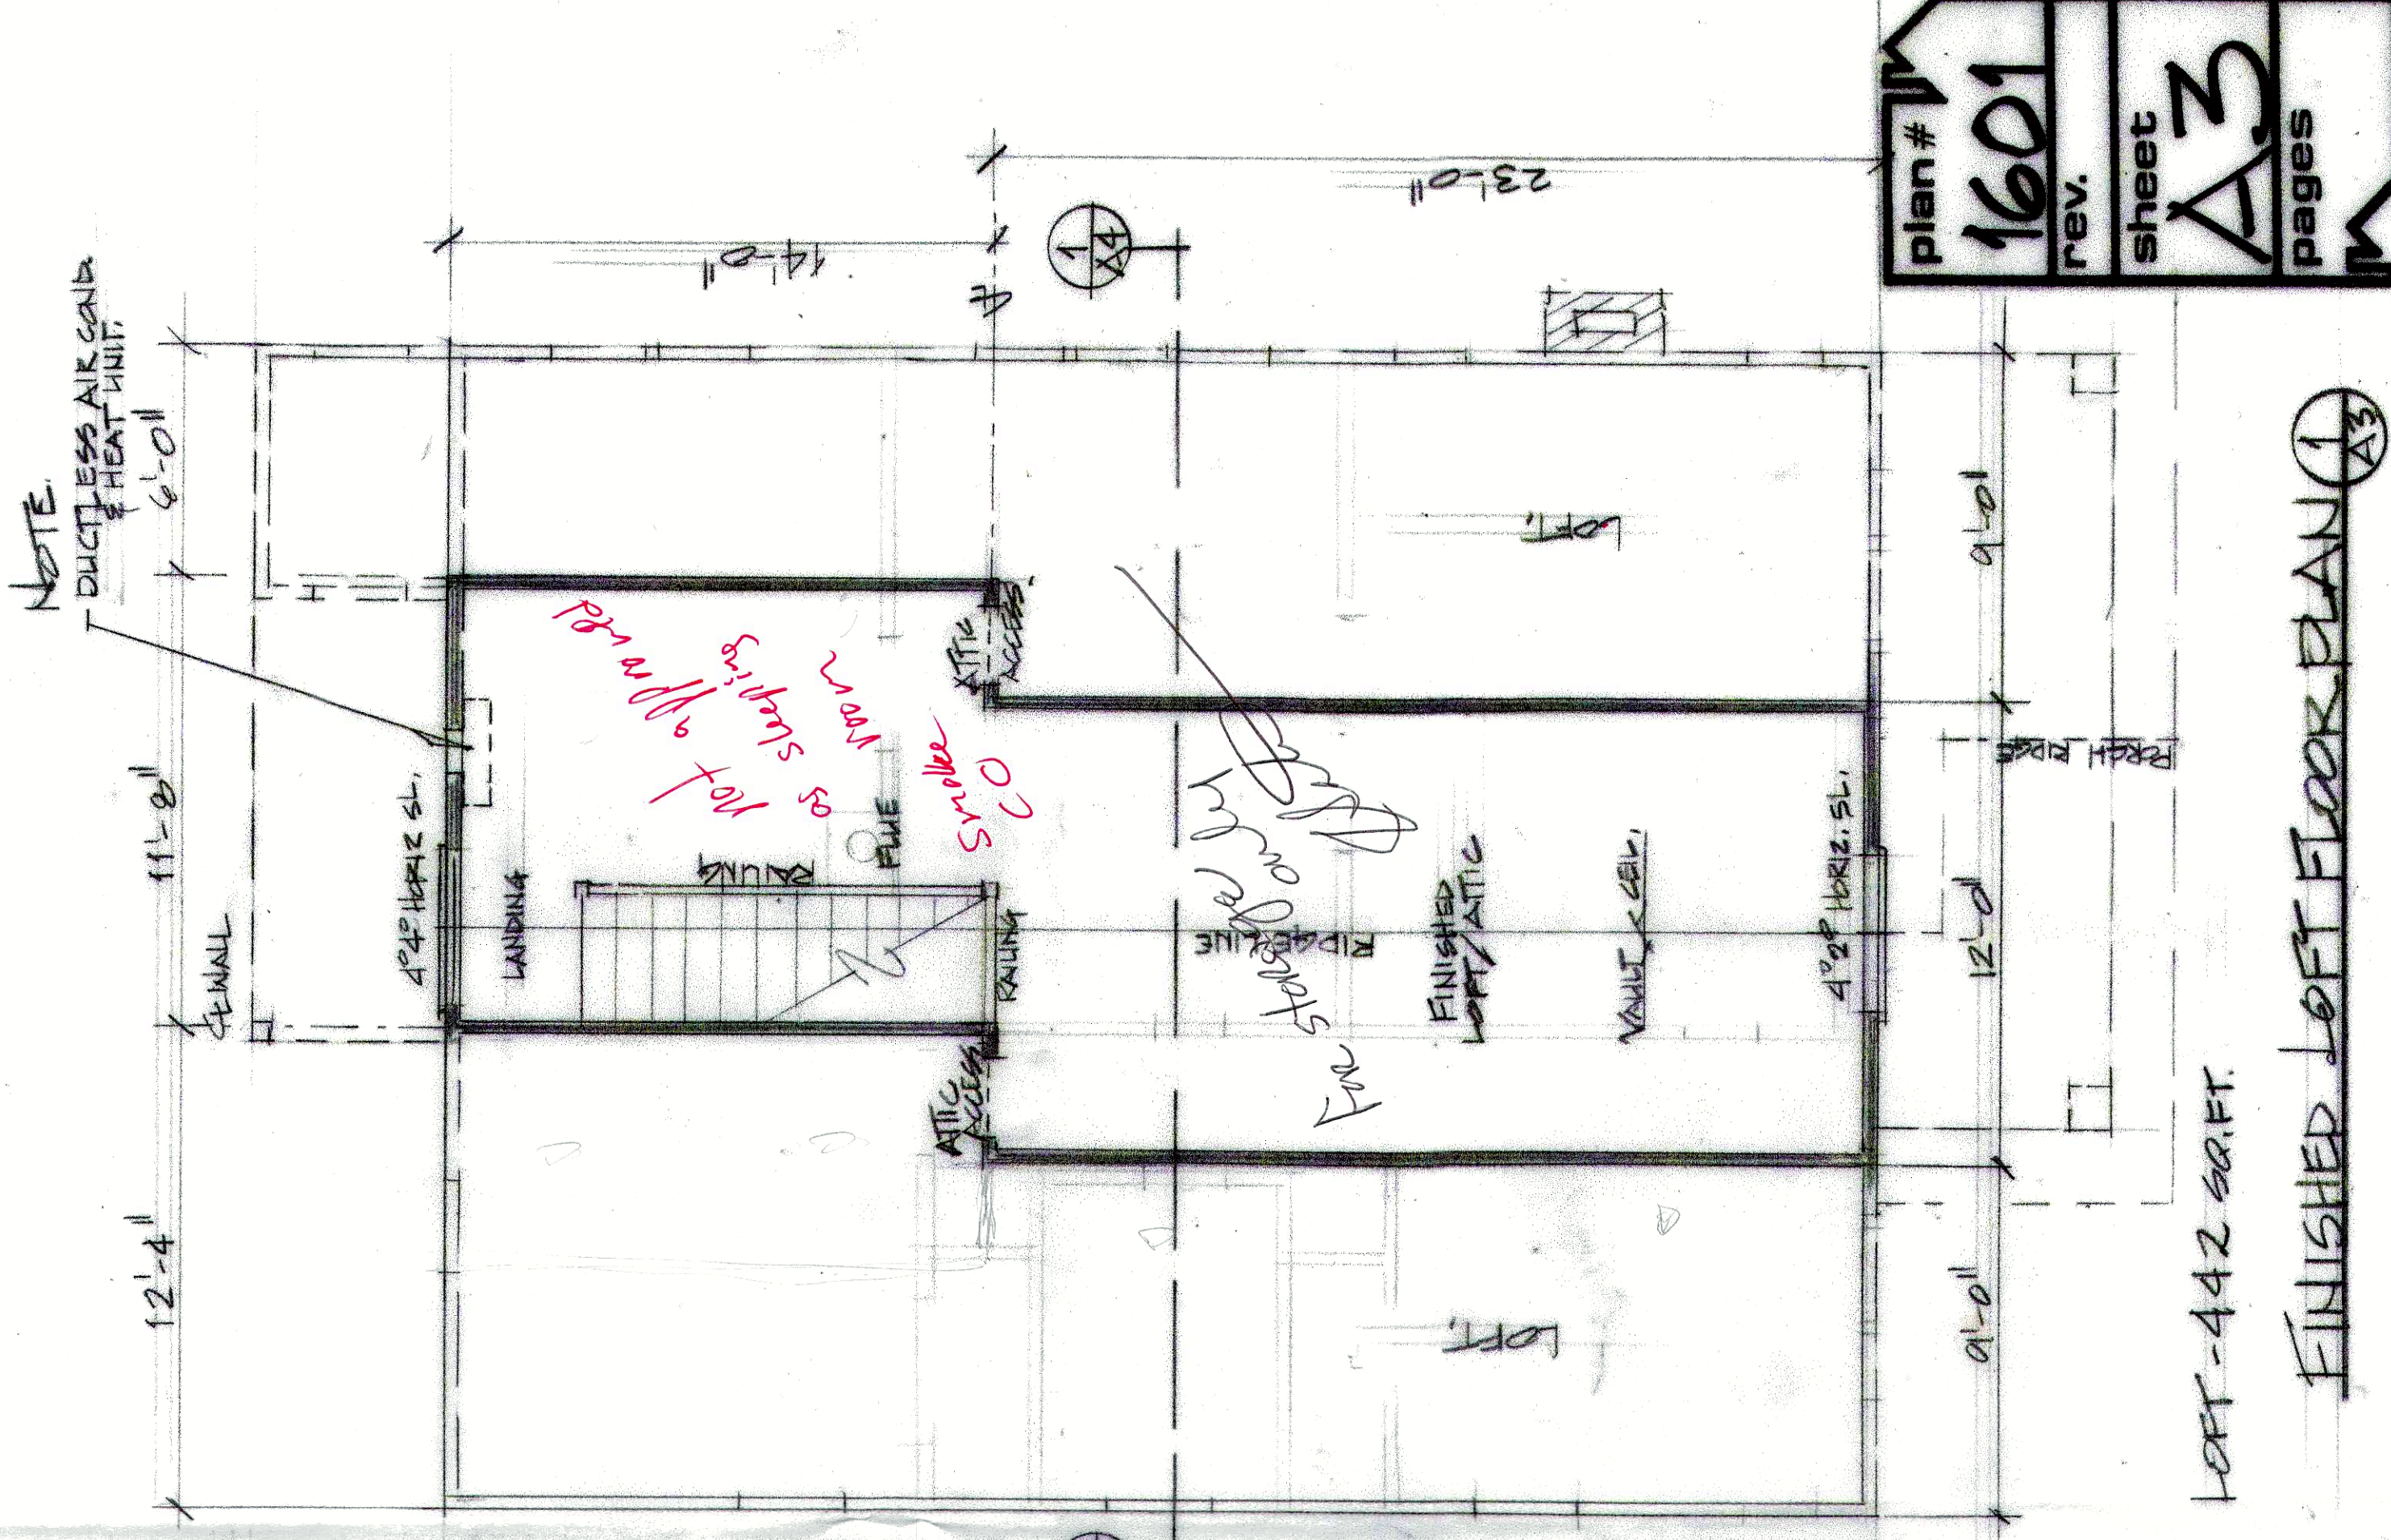


EXIST. BASEMT. CEILING FRAMING. (A3)

PROPOSED LOFT FLOOR FRAMING. (A3)

SCALE: 1/4" = 1'-0"



$$\begin{array}{r} 6.25 \\ \times 13.5 \\ \hline 25 \\ 1875 \\ 15625 \\ \hline 84.375 \end{array}$$


plan #	1601	rev.		sheet	A4	pages	
--------	------	------	--	-------	----	-------	--

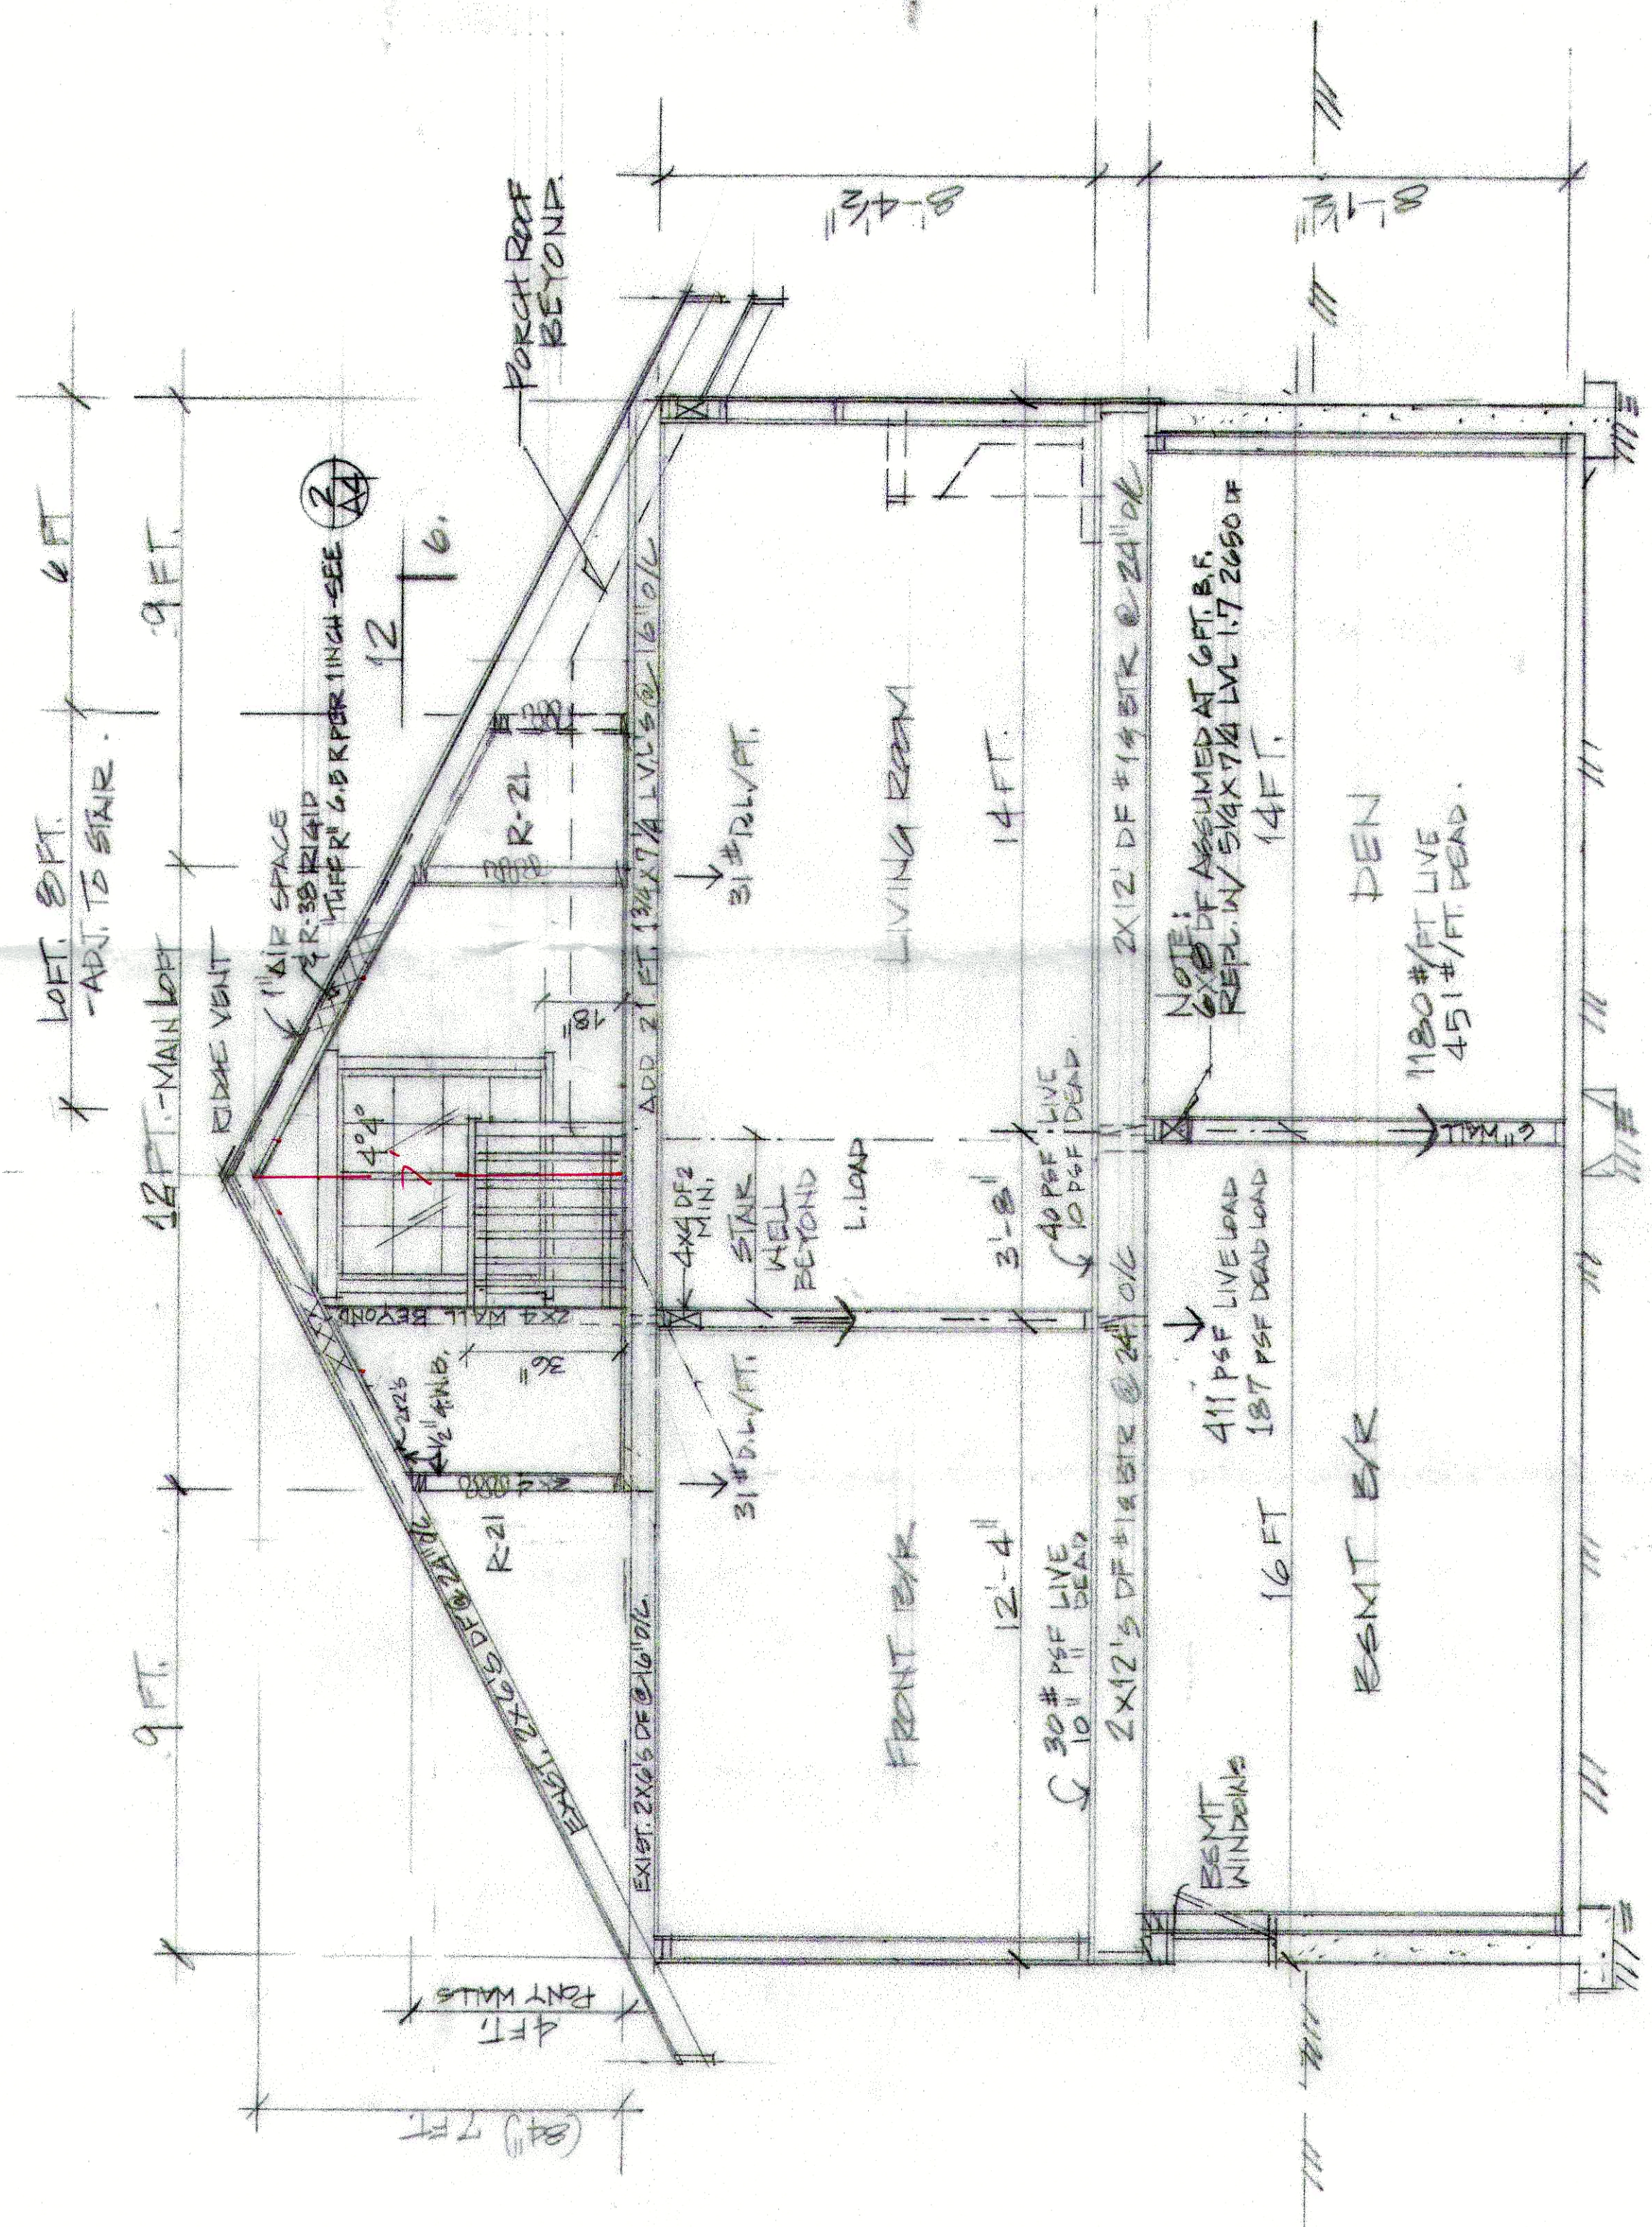

SCALE: $3/8" = 1'-0"$

POST SECTION

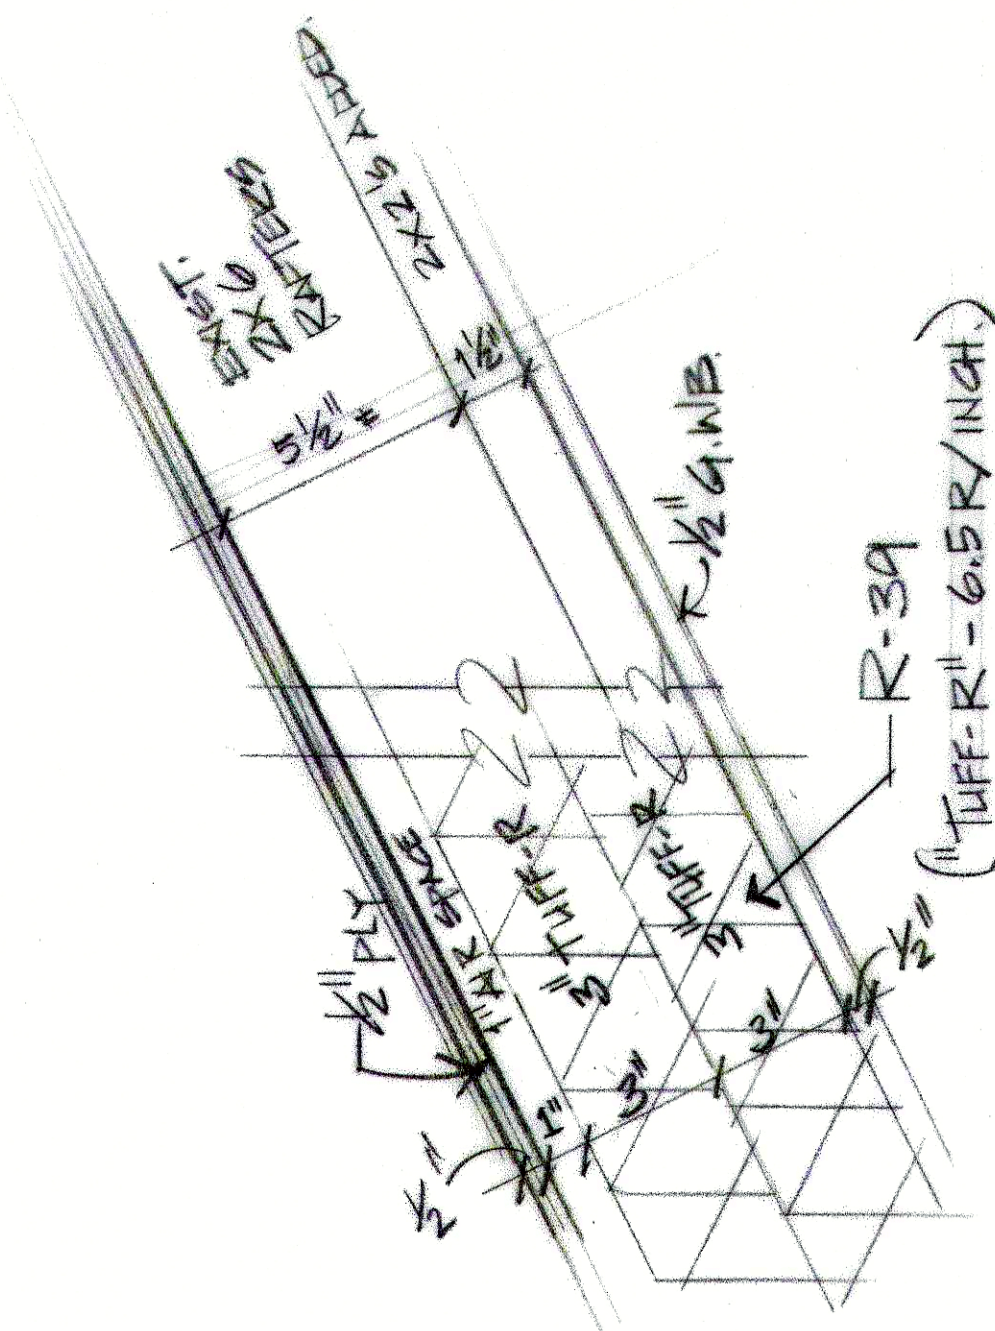

SCALE $\frac{1}{4}'' = 1'$

~~DETAIL~~