

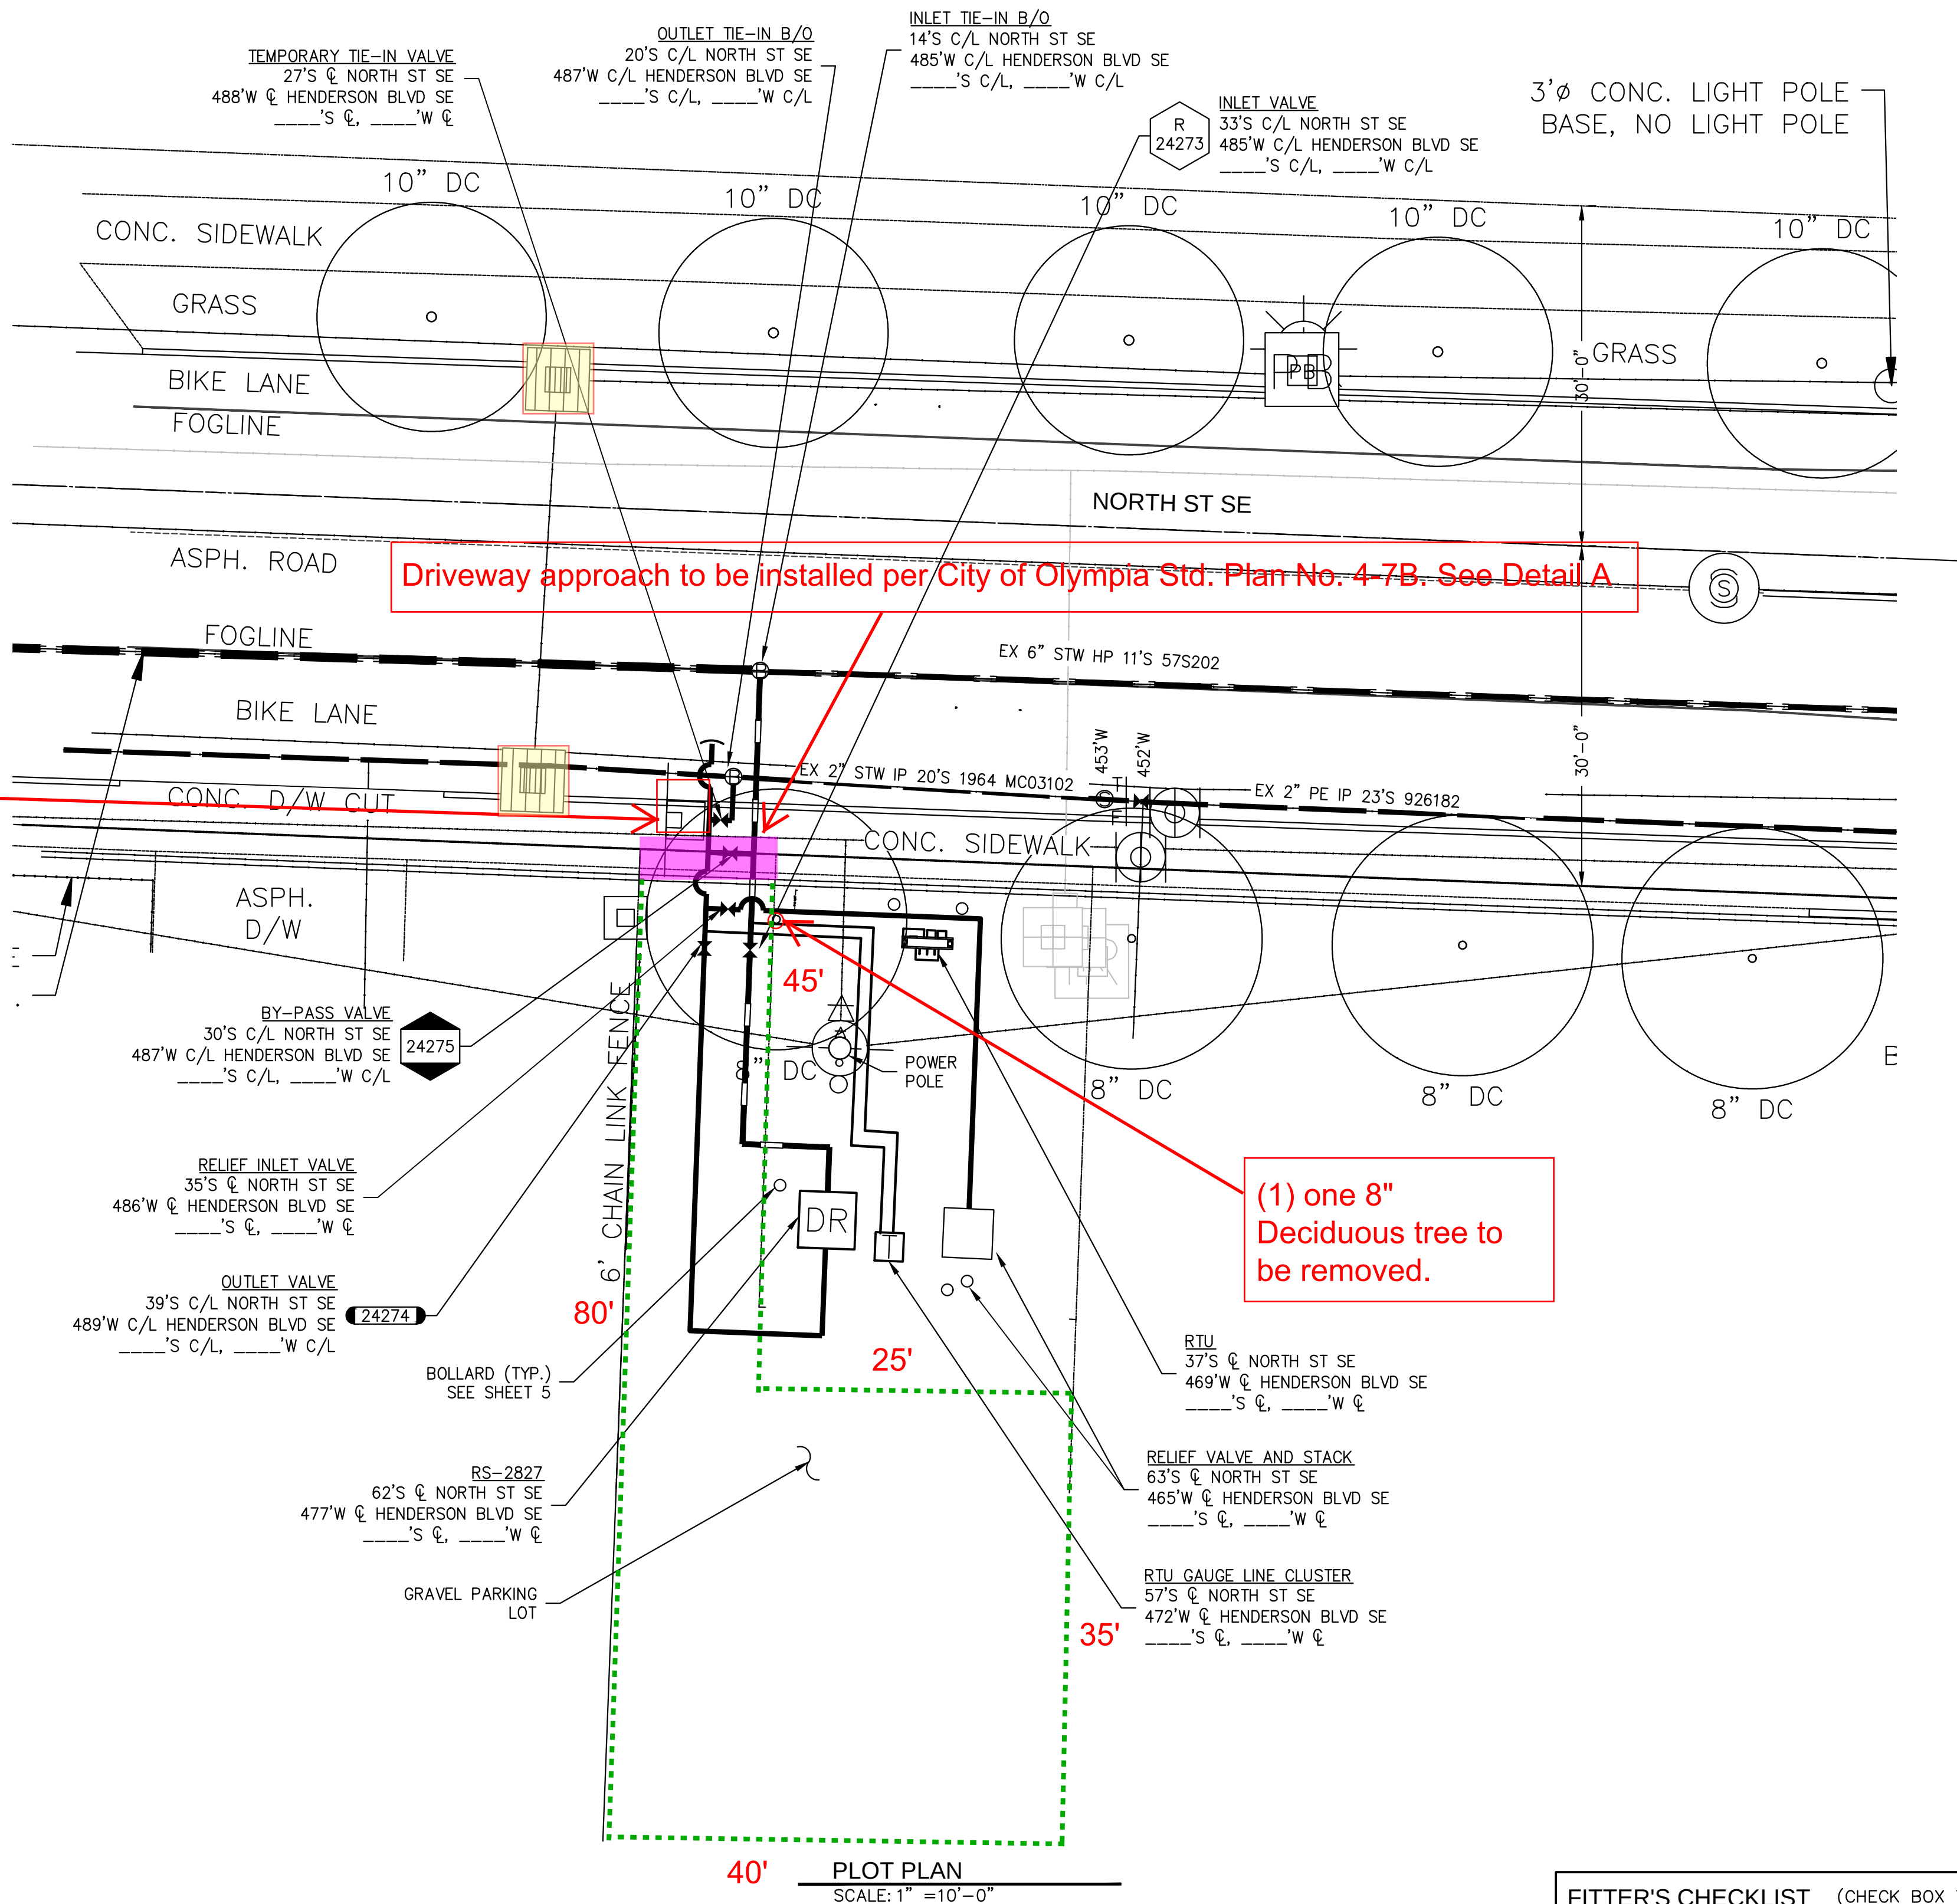


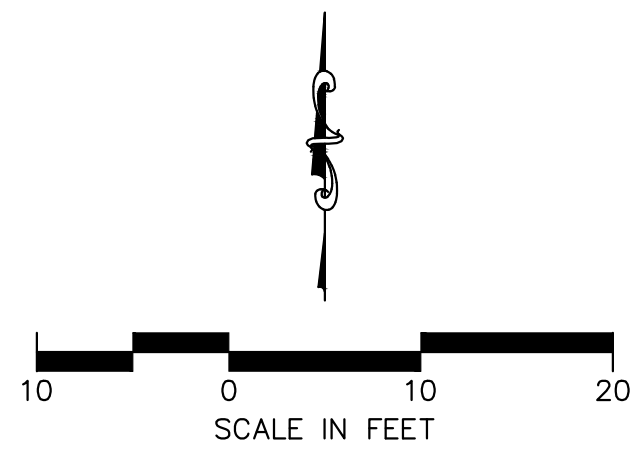

School crossing sign
to be relocated

(1) one 8"
Deciduous tree to
be removed.

Detail A

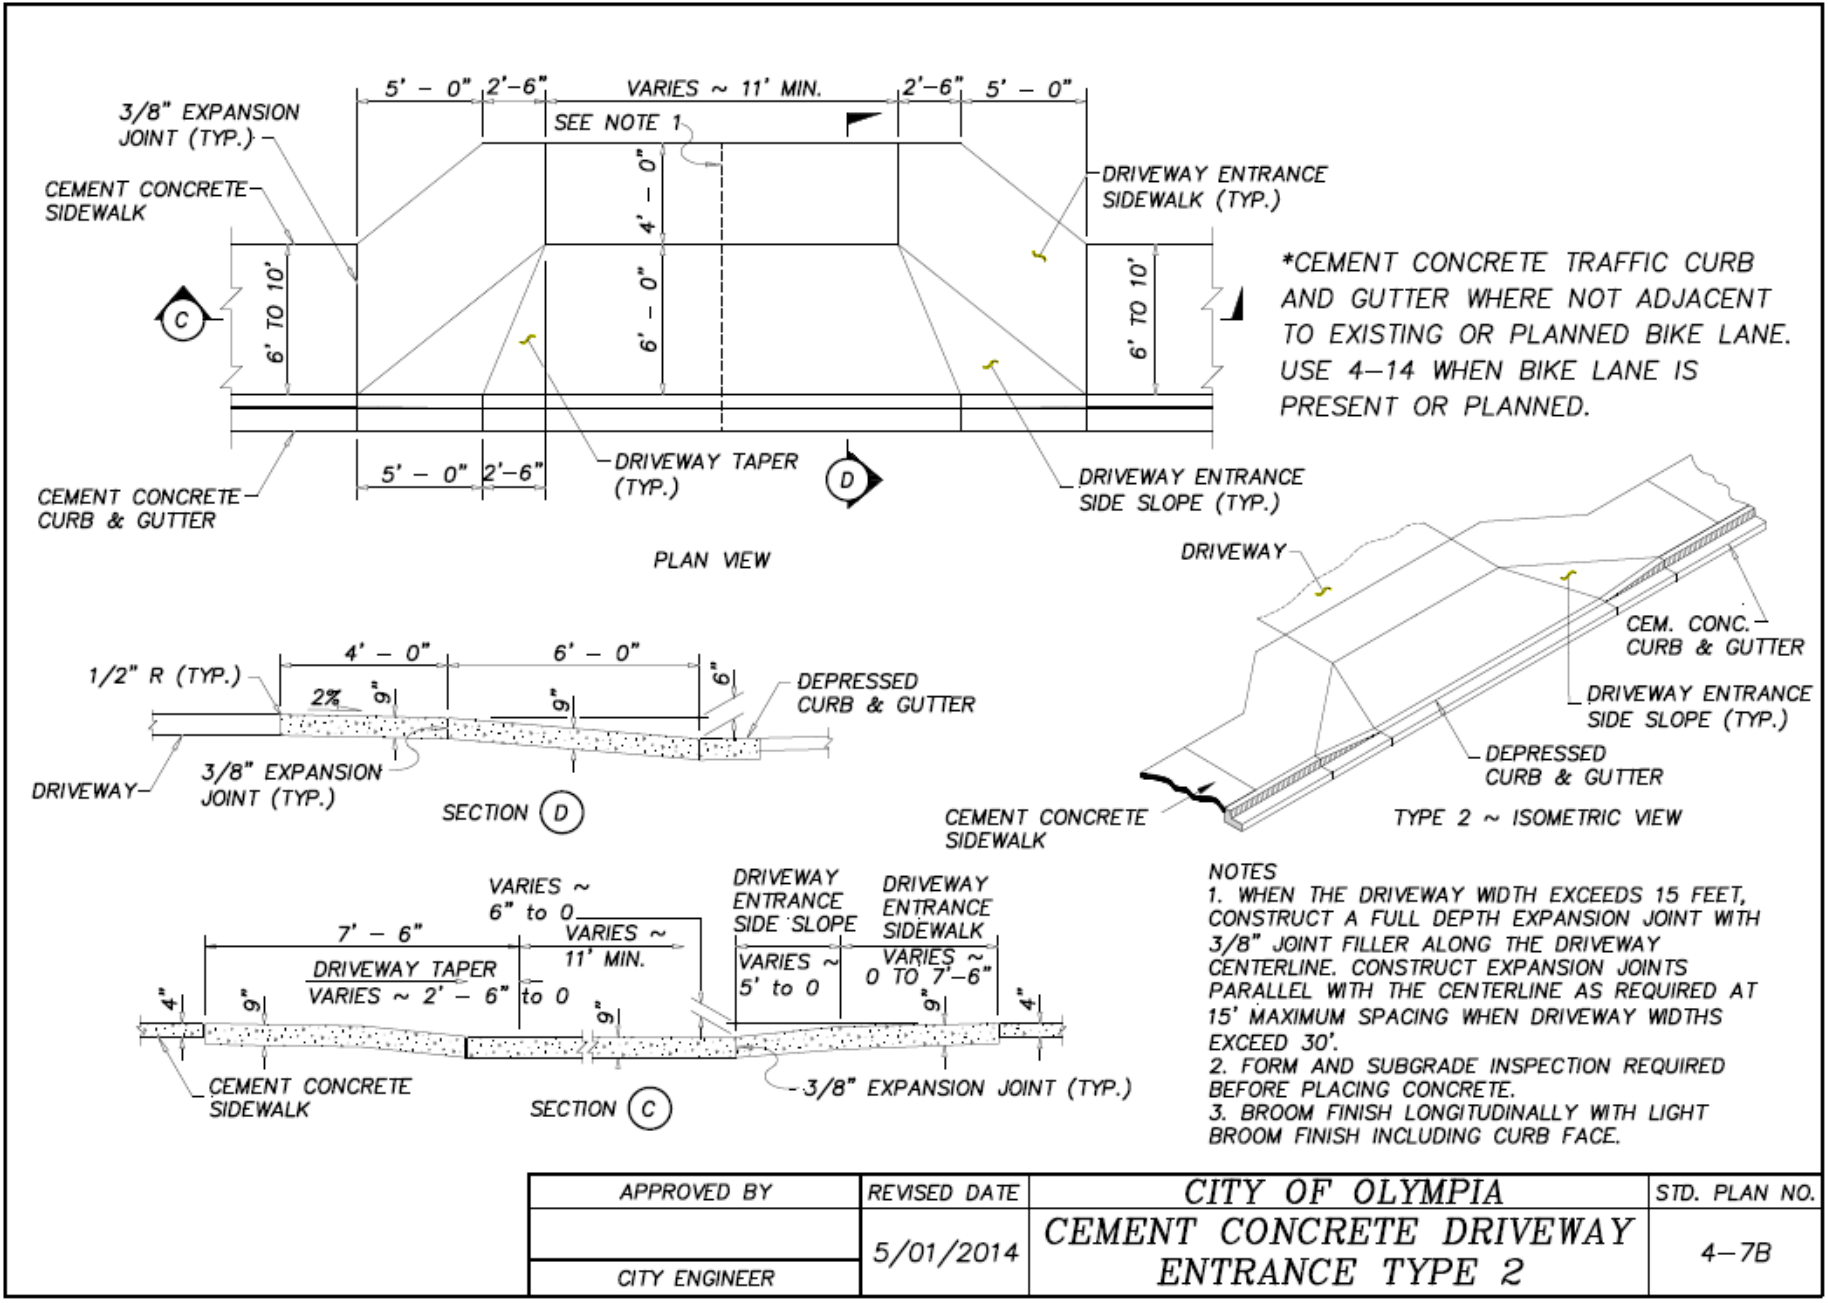

- Gravel area perimeter
- Catch Basin Protection

GAS MAIN PRESSURE AND TESTING					
TEST TYPE	☐ SOAP	☐ AIR	☐ NITROGEN	☐ WATER	
DATE ON	/ /	TIME ON			
DATE OFF	/ /	TIME OFF			
PRESSURE		TEST RESULTS	☐ P ☐ F	TESTED BY	
TEST TYPE	☐ SOAP	☐ AIR	☐ NITROGEN	☐ WATER	
DATE ON	/ /	TIME ON			
DATE OFF	/ /	TIME OFF			
PRESSURE		TEST RESULTS	☐ P ☐ F	TESTED BY	
TESTED BY	PSE PRESSURE CONTROL, SEE FORM 1928				
DESIGN PRESS		SYSTEM MAOP			

FITTER'S CHECKLIST (CHECK BOX TO CONFIRM COMPLETION)

- ☐ INSPECTED STEEL AND PE PIPE PER GOS 2450.1400 AND 2450.1500.
- ☐ REVIEWED AND COMPLIED WITH ALL CONSTRUCTION NOTES.
- ☐ RECORDED ALL REQUIRED INFORMATION ON THE AS-BUILT PER GOS 2500.1700.
- ☐ COMPLETED POST INSTALLATION INSPECTION PER GOS 2525.1200 AND 2525.2700.
- ☐ LEFT THE WORK AREA IN A CLEAN AND SAFE CONDITION.

FOREMAN'S SIGNATURE: _____
FOREMAN'S NAME (PRINTED): _____
COMPANY: _____ DATE: _____

4680 06/11

REV	DESCRIPTION	BY	CHK	CP	ENG	APP	PM	DATE
REVISIONS								

PROJECT MANAGER CONTACT INFO FRANCISCO REYNA 206-471-9742 CELL PHONE francisco.reyna@pse.com EMAIL		THIS SKETCH NOT TO BE RELIED UPON FOR EXACT LOCATION OF FACILITIES		CALL (800) 424-5555 2 BUSINESS DAYS BEFORE YOU DIG	
REAL ESTATE/EASEMENT N/A		PERMIT CITY OF OLYMPIA			
FUNCTION	NAME	PHONE	DATE		
3	-N/A-	N/A	-----N/A-----		
2	-N/A-	N/A	-----N/A-----		
1	-N/A-	N/A	-----N/A-----		
REV #	DATE	BY	DESCRIPTION	CHECKED BY	
COUNTY	EMER SECTION	GAS WK CTR	APPROVED BY	J.EWING	425-424-7824
THURSTON	47	PGRPC015	CP APP	A.MULKEY	206-716-2744
1/4 SECTION	OP MAP	PLAT MAP	MAPPING		
SW 25-18-02W	272.014	273.018			
JOINT FACILITIES ARRANGEMENTS					
UTILITY					
CONTACT					
PHONE					
RS-2827 1601 NORTH ST SE OLYMPIA WA		SAP ORDER NUMBER 109109662 DWG NUMBER 3D12-581 SCALE: AS-NOTED		REV 2/6	